

KANSAS

Marion


Section 5 Township 19 Range 4EWell No. 1 HolubCompany Slusser Drlg. et al

Wildcat

NORTH

WEST

EAST

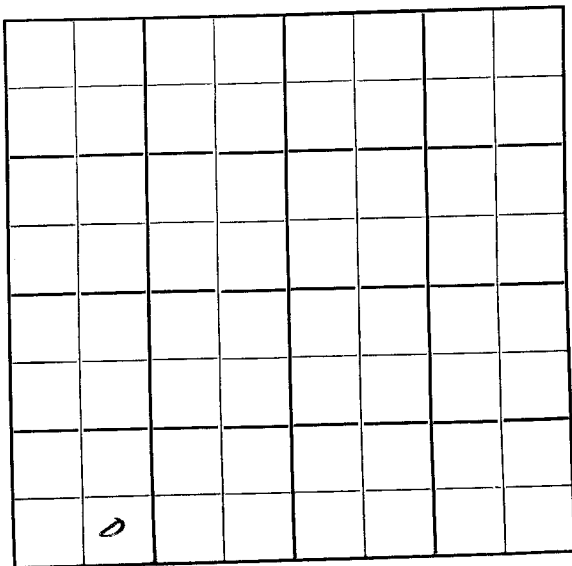

SOUTH

KANSAS

Marion ✓

Sec. 5 Twp. 19 R. 4E

Well No. 1 Holub Farm

Slusser Drlg. et al Company


Slusser Drlg. - Contr. Wildcat

 Ft. from N. Line

330 Ft. from S. Line

 Ft. from E. Line

990 Ft. from W. Line

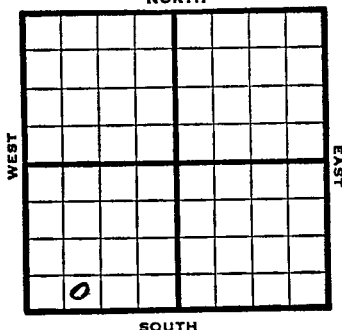

SE SW SW

1949 Elev. 1399' REPORT

9/28	Loc.
10/5	8" @ 100'
	Drlg 2236
10/12	Miss 2360'
	TD 2361
	5" @ 2360'
10/19	TD 2366'
10/26	Flow 30 oil PH 3 hrs SW
	1 1/2 M Gas
11/1	"
11/9	"
11/16	"
11/23	"
11/29	"
12/7	TD 2366'
	Miss 2360'
	5" @ 2360'
	Pump 40 Oil Pot
	36° Gr.
	Comp

COMPLETED


Kansas

Map No. _____ Sec. 5 Twp. 19 R. 4EWell No. 1 Holub

Slusser Drilling, et al. _____ Company

Slusser Drilling _____ Contractor

SE SW SW

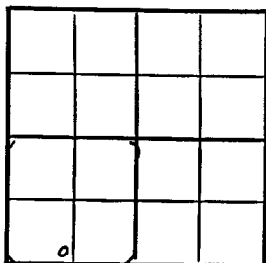FIRST REPORT
SECTION PLAT

_____ Ft. from N. Line

330 Ft. from S. Line

_____ Ft. from E. Line

990 Ft. from W. Line

Marion County

Location X

Rig up _____

Drilling and Remarks:

RECORD

Cased _____ in., _____ ft.

Sand _____

Gas _____

Oil _____

Total Depth _____

PRODUCTION

1st 24 hrs. Nat. _____

1st 24 hrs. after shot _____

Gas _____ Cu. Ft.

Dry Hole _____

Abandoned _____

Date

SEP 28 19

S. J. LEWIS Scout

Kansas

Map No. _____ Sec. 5 Twp. 19 R. 4EWell No. 1 Holub

Slusser Drlg. etal. _____ Company

COMPLETE

Contractor


SE SW SW

E11398
SECTION PLAT

_____ Ft. from N. Line

_____ 330 Ft. from S. Line

_____ Ft. from E. Line

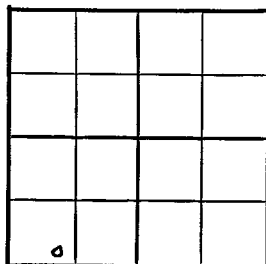_____ 990 Ft. from W. Line

Marion County

Location _____

Rig up _____

Drilling and Remarks:

*Miss 284**5" @ 360'**Pump 4000 ft 50'**862 ft*

RECORD

Cased _____ in., _____ ft.

Sand _____

Gas _____

Oil _____

Total Depth 2766

PRODUCTION

1st 24 hrs. Nat. _____

1st 24 hrs. after shot _____

Gas _____ Cu. Ft.

Dry Hole _____

Abandoned _____

Date

DEC 7 1949

19

S. J. LEWIS

Scout