


Marion

KANSAS

SECTION 5 TOWNSHIP 19S RANGE 4E

WELL NO. 3 ~~#1~~ J. Holub

COMPANY ## Slusser

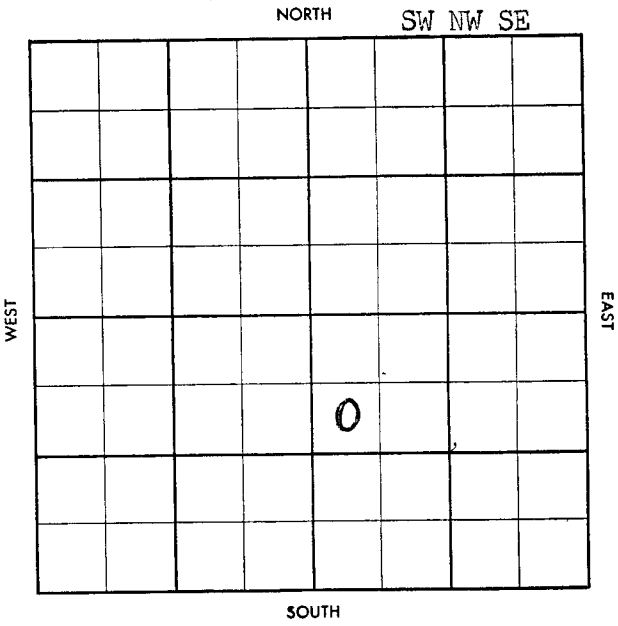

# CORRECTION

9-813-B

~~10~~

County Marion Elev. 1795 ft 1720 ft  
 Sec. 5 Twp. 19 Rge. 4E  
 Company Slusser  
 Farm Name A. Holub No. 3 ±

TOPS	DEPTH	LOG	DATUM
Anh.			
Tp.			
H.			
Tr.			
Dg.			
B. L.			
L.	<u>1835</u>		
K.C.			
B.K.C.			
Ce.			
C.			
M. <u>shot</u>	<u>2370</u>		
M.	<u>2349</u>		
K.			
Mz.			
Mq.			
V.			
S.			
S.			
A.			
R.			
Pf.			
G.			
T.D.	<u>2374</u>		

Loc. in Sec. SW NW SE  
 Geol. \_\_\_\_\_  
 Contr. \_\_\_\_\_  
 Co. tools \_\_\_\_\_  
 Pool Propp

**COMPLETE**

MAR 12 '58

Date Comm. 2-14-58  
8" @ 157 drlg. 2350 5" 2374  
WECT MAR 5 '58 MAR 12 '58 COOD 2411 TD  
Flac pop  
P 2530 pd +70° 10W  
Miss 2376-2411

S-513-B

10

County Mason Elev. \_\_\_\_\_  
 Sec. 5 Twp. 19 Rge. 4E  
 Company Slusser  
 Farm Name J. Holub No. 1

TOPS	DEPTH	LOG	DATUM
Anh.			
Tp.			
H.			
Tr.			
Dg.			
B.L.			
L.			
K.C.			
B.K.C.			
Ce.			
C.			
M.			
M.			
K.			
Mz.			
Mq.			
V.			
S.			
S.			
A.			
R.			
Pf.			
G.			
T.D.			

Loc. in Sec. SW NW SE

Geol. \_\_\_\_\_  
 Contr. \_\_\_\_\_  
Co. tools  
 Pool \_\_\_\_\_  
Propp

FEB 19 1958  
**FIRST REPORT**

Date Comm. 2-24-58  
8" @ 157 drlg. 2350

Co.

Use.

No.

Sec.

T.

R.