


KANSAS

Section 5 Township 19 Range 1-E

Well No. #1 Stauffer

Company Eldorado Ref

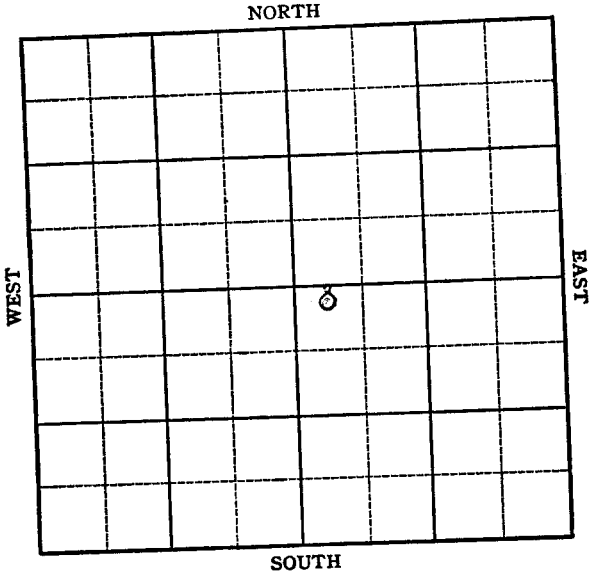

KANSAS

Marion ✓

Sec. 5 Twp. 19 R. 1-E

Well No. #1 Stauffer Farm

Eldorado Ref Company


Leigh Pool

280 Ft. from N. Line

 Ft. from S. Line

 Ft. from E. Line

330 Ft. from W. Line

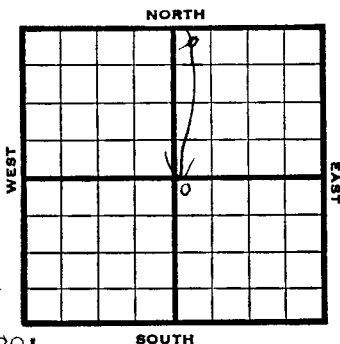

NW SW Elev. 1589'

NE

REPORT

1947

3/5 RUR
3/11 8" @ 200'
fsg 2630'
3/18 Lens 2512'
2630 fsg
3/25 Miss. 2893'
Drlg 2904'
4/2 Arb. 3517'
TD 3558'.

ABANDONED

2893
1589
1304

Kansas KANSAS

Leigh Pool

Map No. _____ Sec. 5 Twp. 19 R. 1EWell No. 1 Stauffer

Eldorado Ref.

Company _____

CORRECTION

Contractor _____

NW SE


280 Ft. from N. Line

_____ Ft. from S. Line

_____ Ft. from E. Line

330 Ft. from W. Line

SECTION PLAT

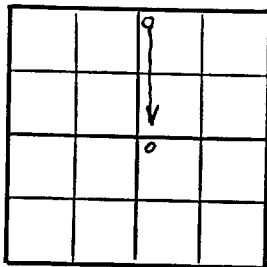

Marion County

Location _____

Rig up _____

Drilling and Remarks:

had spotted
NW NE

RECORD

Cased _____ in., _____ ft.

Sand _____

Gas _____

Oil _____

Total Depth 330

PRODUCTION

1st 24 hrs. Nat. _____

1st 24 hrs. after shot _____

Gas _____ Cu. Ft.

Dry Hole _____

Abandoned _____

Date

MAR 5 1947

19

S. J. LEWIS

Scout

Map No. _____ Sec. 5 Twp. 19 R. 1E

Well No. 1 Stauffer

Eldorado Ref. Company

FIRST REPORT Contractor

NW SE


SECTION PLAT

280 Ft. from N. Line

_____ Ft. from S. Line

200 Ft. from E. Line

330 Ft. from W. Line

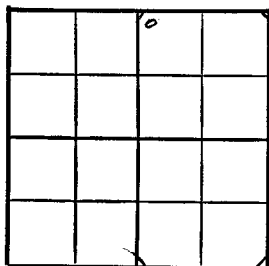

Marion County

Location _____

Rig up _____

Drilling and Remarks:

R U R

RECORD

Cased _____ in., _____ ft.

Sand _____

Gas _____

Oil _____

Total Depth 330

PRODUCTION

1st 24 hrs. Nat. _____

1st 24 hrs. after shot _____

Gas _____ Cu. Ft.

Dry Hole _____

Abandoned _____

Date

MAR 5 1947 19

S. J. LEWIS Scout

Map No. 1524 Sec. 5 Twp. 19 R. 1E

Well No. 1 Stauffer

Eldorado Ref. Company

ABANDONED

Contractor

NW SE


E11588
SECTION PLAT

280 Ft. from N. Line

 Ft. from S. Line

 Ft. from E. Line

330 Ft. from W. Line

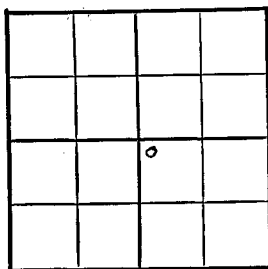

Marion County

Location

Rig up

Drilling and Remarks:

CR 43517

RECORD

Cased in., ft.

Sand

Gas

Oil

Total Depth 3508

PRODUCTION

1st 24 hrs. Nat.

1st 24 hrs. after shot

Gas Cu. Ft.

Dry Hole

Abandoned

Date

APR 2 1947 19

S. J. LEWIS Scout