


Section 5 Township 19 Range 4 E

Well No. # 2 Offner

Company Alpine Oil&Royalty

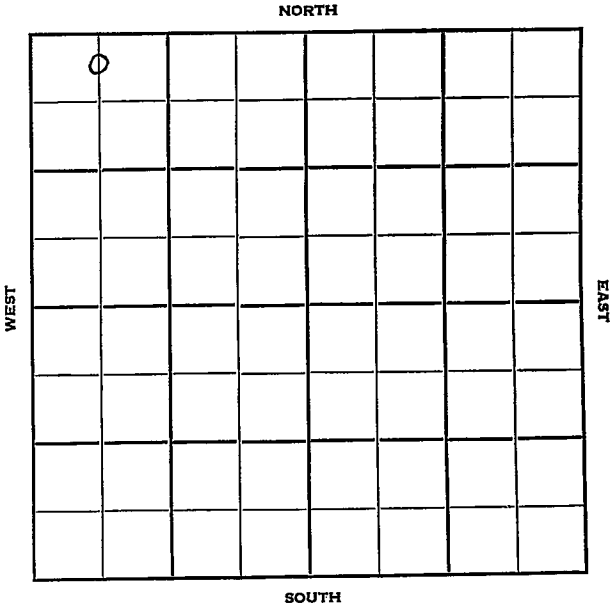

Marion

KANSAS

Sec. 5 Twp. 19 R. 4 E ✓

Well No. # 2 Offner Farm

Alpine Oil & Royalty Company

Contractor

Propp Pool


330 Ft. from N. Line

\_\_\_\_\_ Ft. from S. Line

\_\_\_\_\_ Ft. from E. Line

660 Ft. from W. Line

C N L NW NW

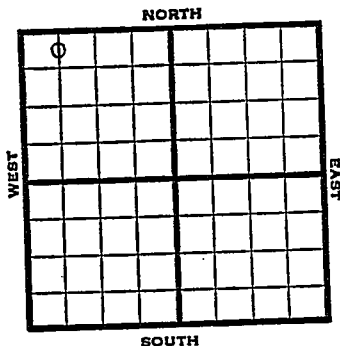

1951

Elev. 1395'

REPORT

4/18

Spud 4-15-51  
8" @ 94  
Drlg. 965'

5/16

Spud 4-15-51  
Oil well TD 2384' 8" @ 94  
Br. line 1757' KC 1807' Miss 2366-  
70' 5 1/2" @ 2368' 1/2 BOPH 1/2 MCFG  
DD 2384' PB 2370'  
Comp. 10 BOPD 1/2 MCFGPD

**COMPLETED**

County Marion State Kansas

Sec. 5 (Blk. Twp.) 19 (Sur. Rge.) 4E Map No.

Operator Alpine Oil & Royalty

Well No. 2 Farm Offner

Elev. Location C N L NW NW

0					

330 Ft. From N Line NW

660 Ft. From W Line Quarter

Ist. Report APR 18 1951

Completion \_\_\_\_\_

Remarks \_\_\_\_\_

Spudding Date 4-15-51

Drlg. Data Propp Pool

8" @ 94 drlg. 965

J. E. TYRA

County Marion State Kansas

Sec. 5 (Blk.) 19 (Sur.) 4E Map No.

Operator Alpine Oil & Royalty

Well No. 2 Farm F. Offner

Elev. 1395 Location C N L NW NW

0					

330 Ft. From N Line NW

660 Ft. From W Line Quarter

1st. Report

Completion MAY 16 1951

Remarks Propp Pool

Spudding Date 4-15-51

Drig. Data Oil well TD 2384

8" @ 94 Br. lime 1757 KC 1807

Miss. 2366-70 5 1/2" @ 2368 1/2 boph

1/2 mcfg DD 2384 PB 2370

Comp. 10 bopd 1/2 mcfgpd

J. C. TYRA