

15-017-20113

KANSAS DRILLERS LOG

API No. 15 — 017 — 20113

County

Number

Operator

Christopher C. Long

Address

3105 East Skelly Drive, Suite 601, Tulsa, Oklahoma

Well No.

Lease Name

#1

Koegeboehn

Footage Location

660' feet from NW (S) line

660' feet from NW (W) line

Principal Contractor

EDCO Drilling

Geologist

John Richard

Spud Date

6-26-78

Total Depth

642'

P.B.T.D.

Date Completed


6-29-78

Oil Purchaser

DF

640 Acres

N

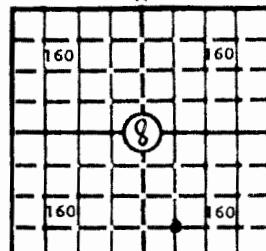

Locate well correctly

Elev.: Gr.

1283'

DF _____ KB _____

CASING RECORD

Report of all strings set—surface, intermediate, production, etc.

Purpose of string	Size hole drilled	Size casing set (in O.D.)	Weight lbs/ft.	Setting depth	Type cement	Sacks	Type and percent additives
Surface	7 5/8	6 5/8		90'		50	
Casing	5 3/4	2 3/8		638'		125	

LINER RECORD

PERFORATION RECORD

Top, ft.	Bottom, ft.	Sacks cement	Shots per ft.	Size & type	Depth interval
			1 HPF		408 to 417

TUBING RECORD

1 HPF

546 to 556

Size	Setting depth	Packer set at

ACID, FRACTURE, SHOT, CEMENT SQUEEZE RECORD

Amount and kind of material used	Depth interval treated
NOT FRACTURED	

INITIAL PRODUCTION

Date of first production		Producing method (flowing, pumping, gas lift, etc.)				
RATE OF PRODUCTION PER 24 HOURS	Oil bbis.	Gas MCF	Water bbis.	Gas-oil ratio CFPB	Producing Interval(s)	
Disposition of gas (vented, used on lease or sold)					Producing Interval(s)	

INSTRUCTIONS: As provided in KCC Rule 82-2-125, within 90 days after completion of a well, one completed copy of this Drillers Log shall be transmitted to the State Geological Survey of Kansas, 4150 Monroe Street, Wichita, Kansas 67209. Copies of this form are available from the Conservation Division, State Corporation Commission, 3830 So. Meridian (P.O. Box 17027), Wichita, Kansas 66217. Phone AC 316-522-2206. If confidential custody is desired, please note Rule 82-2-125. Drillers Logs will be on open file in the Oil and Gas Division, State Geological Survey of Kansas, Lawrence, Kansas 66044.

Operator

DESIGNATE TYPE OF COMP.: OIL, GAS,
DRY HOLE, SWDW, ETC.:

Well No.	Lease Name
----------	------------

S ____ T ____ R ____ E
W**WELL LOG**


Show all important zones of porosity and contents thereof; cored intervals, and all drill-stem tests, including depth interval tested, cushion used, time tool open, flowing and shut-in pressures, and recoveries.

SHOW GEOLOGICAL MARKERS, LOGS RUN,
OR OTHER DESCRIPTIVE INFORMATION.

FORMATION DESCRIPTION, CONTENTS, ETC.	TOP	BOTTOM	NAME	DEPTH

USE ADDITIONAL SHEETS, IF NECESSARY, TO COMPLETE WELL RECORD.

Date Received

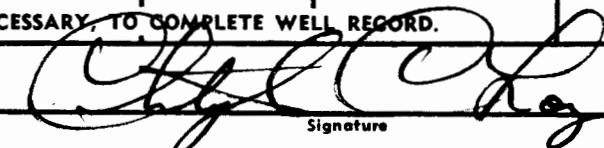
Signature

President

Title

August 24, 1978

Date