


Section 6 Township 19 Range 4E

Well No. #1 Houlb *(Houlb)*

Company Slusser Bros et al

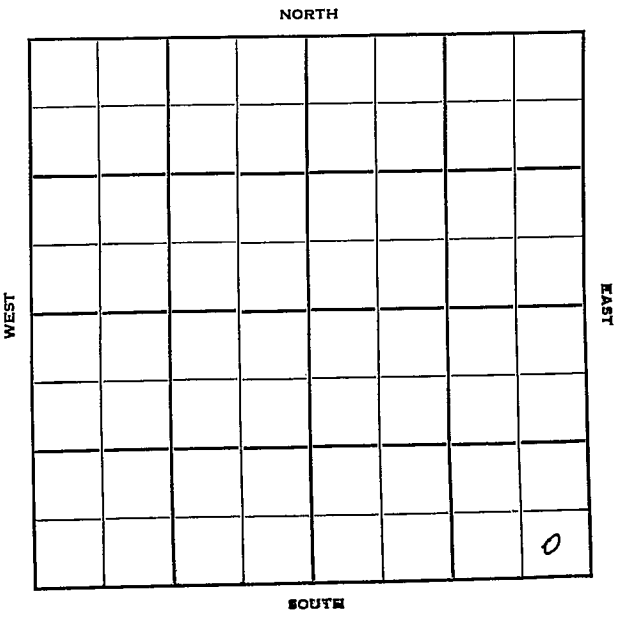

Sec. 6 Twp. 19 R. 4-E

Well No. #1 Houlb Farm

Slusser Bros, et al Company

Contractor

Propp


 Ft. from N. Line

330 Ft. from S. Line

330 Ft. from E. Line

 Ft. from W. Line

SE SE SE

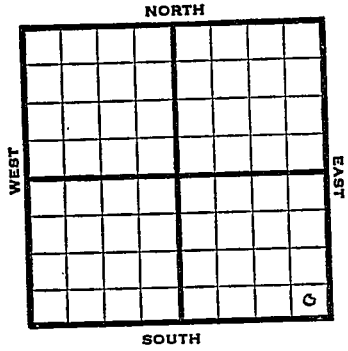

1950

Elev 1409

REPORT

7/26

Rig Up

8/30

Miss 2369

5" @ 2370

TD 2415

Comp. flow Pot. 30 bo 70 bw

400,000 cfcpd

Completed

COMPLETED

Map No. _____ Sec. 6 Twp. 19 R. 4E

Well No. 1 Houlb

Slusser Bros. etal. Company

" " Contractor

SE SE SE

SECTION PLAT



_____ Ft. from N. Line

330 Ft. from S. Line

330 Ft. from E. Line

_____ Ft. from W. Line

Marion County

Location _____

Rig up X

Drilling and Remarks:

RECORD

Cased _____ in., _____ ft.

Sand _____

Gas _____

Oil _____

Total Depth _____

PRODUCTION

1st 24 hrs. Nat. _____

1st 24 hrs. after shot _____

Gas _____ Cu. Ft.

Dry Hole _____

Abandoned _____

Date

JUL 26 1950 19

J. E. TYRA Scout

