


SECTION 7 TOWNSHIP 19 RANGE 2 E

WELL NO. #1 Natzlaff

COMPANY E. K. Carey

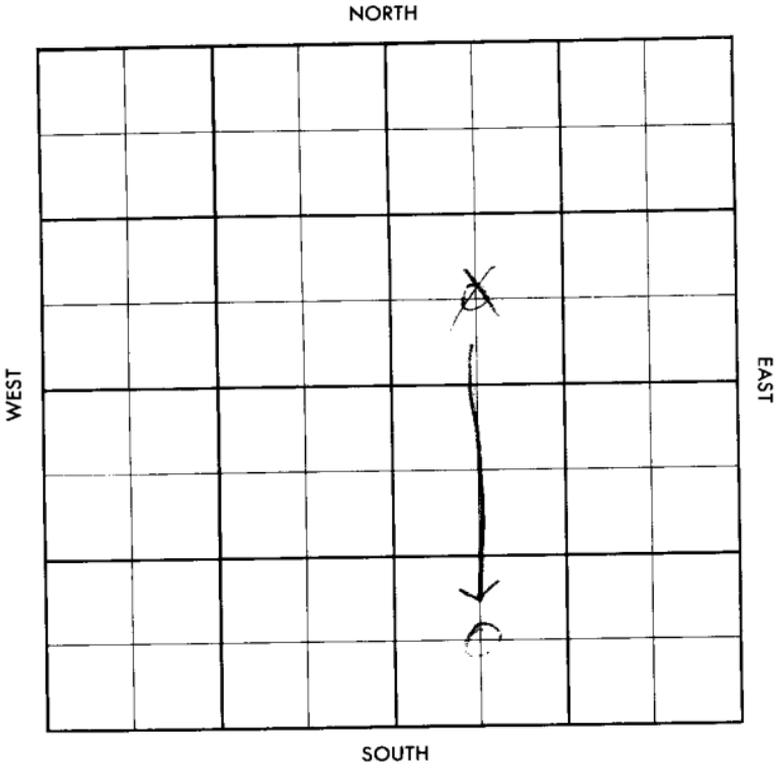

Marion

KANSAS

SEC.

TWP.

R.

17

7

19

2E

WELL NO.

#1 Ratzlaff

FARM

COMPANY

E.K.Carey

CONTRACTOR

Co. Tools

Ratzlaff WILDCAT


Ft. from N. Line

Ft. from S. Line

Ft. from E. Line

Ft. from W. Line

C SW NE
SE

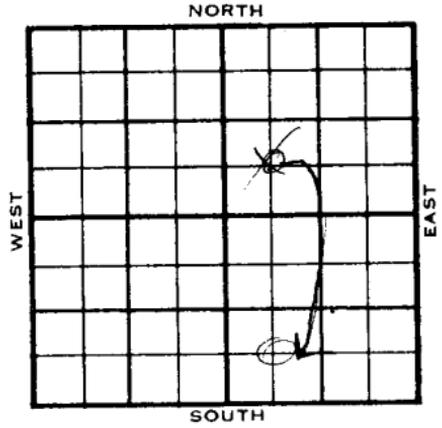

1955	ELEVATION REPORT
12-21	Location

County **Marion** Elev. _____
 Sec. **17** Twp. **19** Rge. **2E**
 Company **E. K. Carey**
 Farm Name **Ratzlaff** No. **1**

TOPS	DEPTH	LOG	DATUM
Anh.			
TP.			
H.			
Tr.			
Dg.			
BL.			
L.			
K.C.			
B.K.C.			
Ce.			
C.			
M.			
M.			
K.			
Mz.			
Me.			
V.			
S.			
S.			
A.			
R.			
Pe.			
G.			
ED.			

Loc. in Sec. **C SW NE**
 Geol. _____
 Contr. _____
Co. tools
 Pool _____
Wildcat
 DEC 21 1955
FIRST REPORT

ate Comm. _____
Location

Co.
Lse.
No.
Sec.
I.
R.

CORRECTION

FORM 812 REV. JANUARY

 Sec. 7 Twp. 19 Rge. 2E
 Company E. K. Carey
 Farm/lease Ratzlaff No. 1

TOPS	DEPTH	LOG	DATUM	Loc. in Sec.																
Ant.				C SW NE SE																
Top																				
H.																				
Tr.																				
Dp.																				
Bl.																				
L.																				
EC	2100		629	Geol.																
BRC				Cont.																
Co.				Co. tools RATZLAFF																
C.																				
M.	2203		1231	Bl. inst.																
N.	Base 2295		1424																	
R.				<table border="1" style="width: 100%; height: 100%; border-collapse: collapse;"> <tr><td style="width: 25%; height: 25%;"></td><td style="width: 25%; height: 25%;"></td><td style="width: 25%; height: 25%;"></td><td style="width: 25%; height: 25%;"></td></tr> <tr><td style="text-align: center;">X</td><td></td><td></td><td></td></tr> <tr><td style="text-align: center;">COMPLETE</td><td></td><td></td><td></td></tr> <tr><td style="text-align: center;">o</td><td></td><td></td><td></td></tr> </table>					X				COMPLETE				o			
X																				
COMPLETE																				
o																				
Ma.																				
V.	3125		1664																	
S.																				
S.																				
A.																				
R.																				
PC.																				
G.																				
SA	3140																			

Date Com. FEB 22 1956

Location DEC 30 '56 JAN 5 '56 1-3-56
852 140 WOC JAN 11 '56
10 2372 JAN 13 '56 DST 2104-25 WOC 1
hr 9 m 30 seconds 90 2 330M
see 180 WTR BHP 780 FF 282
-450 DST 3126 38 30" WOC 5
Md + 222 BHP 1935 DST 3125 40
1hr 1100 gpm sec 330' 954 WOC
+ 60' Md gpm BHP 1035 542 3112

JAN 25 '56

ca 3140 \$ 6 1/2 Bopk

+ 2 1/2 wtr

POT

FEB 1 '56

FEB 21 '56

FEB 15 '56

FEB 22 '56

Ph P. 88 Bopk +

2 1/2 wtr

gravel 30"

R. G.
MAR 1 1956