

Map No. KANSAS Sec. 7 Twp. 19 R. 3 ^E

Well No. Shaffer O & R Farm Shaffer O & R Company

NORTH

0							

WEST

EAST

SOUTH

Location.....

Drilling Remarks

.....

.....

RECORD

Cased..... in..... ft.

Sand.....

Gas.....

Oil.....

Total Depth.....

Rig Up.....

Drilling Remarks

.....

.....

PRODUCTION

1st 24 hrs. Nat.....

1st 24 hrs. after shot.....

Gas..... cu. ft.....

Dry Hole.....

Abandoned.....

Map No. KANSAS Sec. 7 Twp. 19 R. 3E


Well No. 1- Melcher Farm
Shaffer O & R Company

990 Ft. from N. Line

_____ Ft. from S. Line

_____ Ft. from E. Line

330 Ft. from W. Line

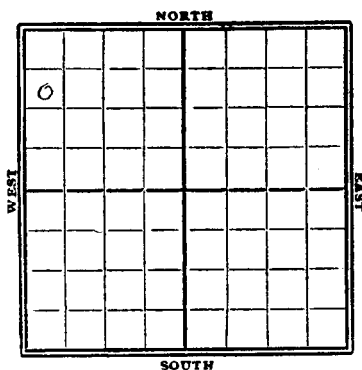

1929

Date	REPORT
1/30	Location
2/16	Bldg Rig
2/13	
2/20	Rig
2/27	Spud 325'
3/6	" 510'
3/13	Drly 1064'
3/20	" 1300'
3/27	" 1825'
4/3	" 2397'
4/10	top chat 2420. 777 ga 2439-42 show oil and water - T.D. 2497-5.1
4/17	Top Viola line 2803' at 2808-2820 had 900' oil in hole in 10 hr
4/24	Viola line 2803-22 shot 15 & 30 gts swab 2 1/2 bbls hour
5/1	drly 2865' swab 575 bbl per day (over)

5/8- T.D. 2937' - HFW
P.B. to 2825'
swab 50 bbls oil
5/15- sand 2803-2937
T.D. 2937' - HFW
P.B. to 2823'
18 bbls oil
Comp.

MAP NO. KANSAS SEC. 7 TWP. 19 R. 3E

WELL NO. K24 1 Shaffer

Shaffer Oil & Ref. COMPANY
CONTRACTOR

SECTION PLAT

0			

990 FT. FROM N. LINE

FT. FROM S. LINE

FT. FROM E. LINE

330 FT. FROM W. LINE

REPORTS

LOCATION ✓

RIG UP

DRILLING AND REMARKS:

RECORD

CASED _____ IN. _____ FT.

SAND _____

GAS _____

OIL _____

TOTAL DEPTH _____

PRODUCTION

1ST 24 HRS. NAT. _____

1ST 24 HRS. AFTER SHOT _____

GAS _____ CU. FT.

DRY HOLE _____

ABANDONED _____

DATE

JAN 30 1929

192

S. J. LEWIS

SCOUT

24 **KANSAS** Marion
 Map No. Sec. 7 Twp. 19 R. 3²

Well No. 1 Melcher
 Shaffer Oil Co. Company

Contractor

COMPLETE

SECTION PLAT

0			

990 Ft. from N. Line

Ft. from S. Line

Ft. from E. Line

330 Ft. from W. Line

Location

Rig up

Drilling and Remarks:

PB to 2823'

18 BB

RECORD

Cased in. ft.

Sand 2803-2937'

Gas

Oil

Total Depth 2937' HFH

PRODUCTION

1st 24 hrs. Nat.

1st 24 hrs. after shot

Gas Cu. Ft.

Dry Hole

Abandoned

Date

MAY 15 1929

CHAS. L. SHERWOOD

192

Scout