


Map No. KANSAS Sec. 7 Twp. 19 R. 3E  
Well No. 1 - ~~Russell~~ WIEMS Farm  
Courtney Davis Company  
NORTH (Weins)

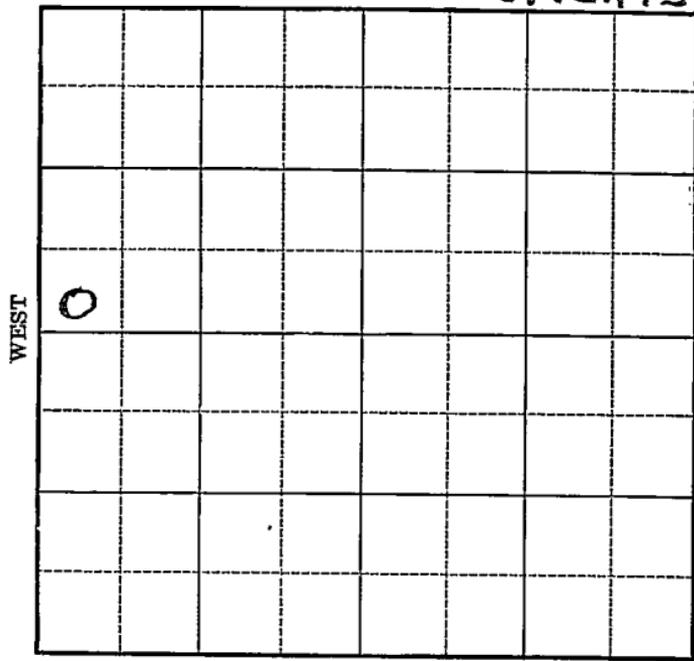

Location \_\_\_\_\_

Rig Up \_\_\_\_\_

Drilling Remarks \_\_\_\_\_

Drilling Remarks \_\_\_\_\_

\_\_\_\_\_  
\_\_\_\_\_  
RECORD

PRODUCTION

Gased \_\_\_\_\_ in. \_\_\_\_\_ ft.

1st 24 hrs. Nat. \_\_\_\_\_

Sand \_\_\_\_\_

1st 24 hrs. after shot \_\_\_\_\_

Gas \_\_\_\_\_

Gas \_\_\_\_\_ cu. ft.

Oil \_\_\_\_\_

Dry Hole \_\_\_\_\_


Total Depth \_\_\_\_\_

Abandoned \_\_\_\_\_

Map No. **KANSAS** Sec. **7** Twp. **19** R. **3E**

Well No. **1- ~~Ramrod~~** Farm  
**Courtney Davis** Company

\_\_\_\_\_ Ft. from N. Line  
**300** Ft. from S. Line  
 \_\_\_\_\_ Ft. from E. Line  
**300** Ft. from W. Line

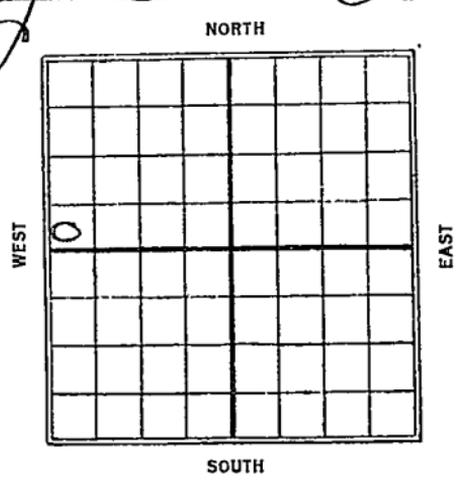

**1928**

Date	REPORT
4/18	Location
4/25	—
5/2	—
5/9	—
5/16	Bldg rig
5/23	Rig
5/31	Drlg 400
6/6	Show oil & gas 596-610. drilling 710-
6/13	T.D. 1050 — u.R. 10 1/2"
6/20	Drlg 1250
6/27	" 1400
7/3	T.D. 1400 — fishing tools.
7/11	Skid Rig
7/18	—
7/25	Spud
8/1	No report.
8/7	Drlg 1060
8/15	" 1600'
8/22	" " 1836
9/5	" " 1880'
9/12	" " 2155

4/3 - Wilcox 2879-95' water  
P.B. to 2820 - swab  
109 bbls - 24 hrs.  
now running  
tubing.

4/8 - 265 bbls


4/10 - Viola lime 2807-15'  
Wilcox sand 2879-95'  
P.B. to 2820'  
shot 20 gts 2812-20'  
T.D. 2820'

Pump 260 bbl oil  
Soup.

Map No. **KANSAS** Sec. 7 Twp. 19 R. 3<sup>E</sup>

Well No. 1 - Rampel Farm  
Sourtruy Davis Company

..... Ft. from N. Line  
300 Ft. from S. Line  
 ..... Ft. from E. Line  
300 Ft. from W. Line

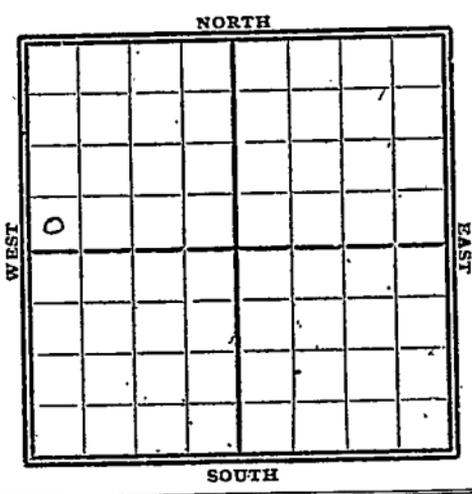

1928

Date	REPORT
12/15	14 bbls oil - 25 water 400# back pressure
12/12	8 bbls oil - 160 bbls water
12/19	8 " " - 100 " "
12/26	—
1929	
1/2	8 bbls oil - 60 bbl water
1/9	12 " oil 60 " water
1/16	12 " " 60 " "
1/23	12 " " 60 " "
1/30	Re-bldy Rig
2/16	—
2/13	— Viola 2807-65
2/20	Rign up.
2/27	—
3/6	UIR 6" - 2536' T.D.
3/13	UIR 2560'
3/19	Top Wilcox 3407' T.D. 3445' - Swab
	10 bbls from Wilcox
3/26	Wilcox 2879 - 95 water PB. to 2820 - swab 24 hrs. <sup>109 bbl</sup>

9/19 - 6" @ 2285'

10/19 2295'

9/26 - Top chat 2424 S.D. 2441  
1 1/2 m gas 2427'

9/26 - T.D. 2444 UIR 6"

10/3

10/5 - Top chat 2425 had  
1,900,000 gas at 2441'  
5,800,000 .. at 2445'  
8,000,000 .. .. 2447'  
8,500,000 .. .. 2458' T.D.

will shut in, spraying  
about 40 bbls per day Est

10/6 - 8 1/2 m gas T.D. 2458'  
Est at 10 bbls oil day

10/10 - T.D. 2458 -

8 1/2 m gas - 10 bbl oil  
gas & oil broke in between  
6" & 8"

10/17 - 193 bbls 36 hrs. 10% water  
31.6 gravity. Making  
3 bbls hr. under 570  
lbs. back pressure

10/24 - making 20 bbls day  
650# back pressure

10/31

11/7 - 147 bbls oil 15 hrs  
100# B.P. will deepen

11/9 - Top chat 2441 - 62  
105 bbls yesterday  
cut 56%

11/13 - 100 bbls fluid 100# B.P.  
60% water T.D. 2462'

11/20 - 8 1/4 bbls oil - 25 bbl water  
350# back pressure

11/28 - 25 bbls oil 25 water  
450# back pressure

O.W.W.O.

10

S-513-B

County Marion Elev. 1347  
 Sec. 7 Twp. 19 Rge. 3E  
 Company Aladdin  
 Farm Name Wiens No. 1

TOPS	DEPTH	LOG	DATUM
Anh.			
Tp.	1315		
H.			
Tr.			
Dg.			
B.L.			
L.	1869		
K.C.			
B.K.C.			
Ce.			
C.	2425		
M.	2505		
M. B			
K.			
Mz.			
Mq.	2004		
V. Wilcox	2079		
S.			
S.			
A.			
R.			
Pf.			
G.			
T.D.			

Loc. in Sec. SW SW NW  
OWWO  
 Geol. U<sub>2</sub> U<sub>3</sub> U<sub>4</sub>  
 Contr. \_\_\_\_\_  
 Pool Hillsboro

**COMPLETE  
FIRST REPORT**  
 MAR 12 1988

Date Comm. OTD 2895 5" @ 2777 FB 2500  
44/ 2442-53 16/ 2426-30  
Comp. 3,400,000 cfg

Co.

Loc.

No.

Sec.

T.

R.

Map No. 24 **KANSAS** Sec. 7 Twp. 19 R. 3E

Well No. 1 Rampel

Courtney Davis Company

S Contractor

**SECTION PLAT**

-----Ft. from N. Line

300 Ft. from S. Line

-----Ft. from E. Line

300 Ft. from W. Line

0			

**FIRST REPORTS**

Location ✓-----

Rig up -----

Drilling and Remarks:

**RECORD**

Cased ----- in., ----- ft.

Sand -----

Gas -----

Oil -----

Total Depth -----

**PRODUCTION**

1st 24 hrs. Nat. -----

1st 24 hrs. after shot -----

Gas ----- Cu. Ft.

Dry Hole -----

Abandoned -----

Date

**APR 18 1928**

**S. J. LEWIS**

Scout

192

*Marion*

MAP NO. KANSAS SEC. 7 TWP. 19 R. 3E

WELL NO. K24 / Views

Courtesy Davis COMPANY  
 \_\_\_\_\_ CONTRACTOR

**SECTION PLAT**

0			

\_\_\_\_\_ FT. FROM N. LINE

300 FT. FROM S. LINE

\_\_\_\_\_ FT. FROM E. LINE

300 FT. FROM W. LINE

**CORRECTION**

LOCATION \_\_\_\_\_

RIG UP \_\_\_\_\_

DRILLING AND REMARKS:

*Reported  
 Rampel Farm*

**RECORD**

CASED \_\_\_\_\_ IN. \_\_\_\_\_ FT.

SAND \_\_\_\_\_

GAS \_\_\_\_\_

OIL \_\_\_\_\_

TOTAL DEPTH \_\_\_\_\_

**PRODUCTION**

1ST 24 HRS. NAT. \_\_\_\_\_

1ST 24 HRS. AFTER SHOT \_\_\_\_\_

GAS \_\_\_\_\_ CU. FT.

DRY HOLE \_\_\_\_\_

ABANDONED \_\_\_\_\_

DATE

JAN 30 1929

S. J. LEWIS

192

SCOUT

Map No. KANSAS Sec. 7 Twp. 19 R. 35

Well No. 24 1 Niems

Courtesy Davis Company

Contractor

SECTION PLAT

0			

..... Ft. from N. Line

300 Ft. from S. Line

..... Ft. from E. Line

200 Ft. from W. Line

**COMPLETED**

RECORD

Location.....

Cased.....in., .....ft.

Rig up.....

Sand.....

Drilling and Remarks:

Gas.....

*Viola Lurie 2807 & 2815*

Total Depth 2820

*Pilot Sol. 2879 & 2890*

*Plugged back & 2820*

*Shot 209 to 2812-20*

*Pumped 260 H.H.*

PRODUCTION

1st 24 hrs. Nat.....

1st 24 hrs. after shot.....

Gas.....Cu. Ft.

Dry Hole.....

Abandoned.....

Date

APR 10 1929

S. J. LEWIS Scout