

Marion

KANSAS

| | | |
|------|------|-----|
| SEC. | TWP. | R. |
| 67 | 19 | 4 E |

WELL NO. # 1 Ernest Holub FARM

COMPANY Slusser Drlg.

CONTRACTOR


Lost Springs Pool

990 Ft. from N. Line

Ft. from S. Line

330 Ft. from E. Line

Ft. from W. Line

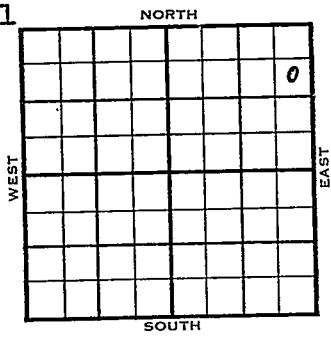

SE NE NE

| 1954 | ELEVATION | REPORT |
|-------|---|-----------|
| 12/1 | Spud 11-29-54 8" @ 80 | |
| 12/29 | Spud 11-29-54 8" @ 80' Miss 2345' TD 2347' 5" @ 2347' DD 2387 D & A | ABANDONED |

Map No. _____ Sec. 7 Twp. 19 R. 4E

Well No. 1 Ernest Holub

Slusser Drlg. Company

CORRECTION Contractor

SE NE NE

SECTION PLAT

990 Ft. from N. Line

_____ Ft. from S. Line

330 Ft. from E. Line

_____ Ft. from W. Line

| | | | |
|--|--|--|---|
| | | | |
| | | | o |
| | | | |
| | | | |
| | | | |

Marion County

Location _____

Rig up _____

Drilling and Remarks:

Reported
6-19-4E

RECORD

Cased _____ in., _____ ft.

Sand _____

Gas _____

Oil _____

Total Depth _____

PRODUCTION

1st 24 hrs. Nat. _____

1st 24 hrs. after shot _____

Gas _____ Cu. Ft.

Dry Hole _____

Abandoned _____

Date

DEC 15 1954

19

FABEN GUN STRAP Scout