

State Kansas County Marion

Company Messman-Rinehart Oil Co. Well No. 1


Farm Boettcher

Survey _____

Block No. _____ Sec. 7 Twp. 19 S Range 5 E

Co-Ord. _____ Elev. 1426' K/B
1424' D/F

Ctr. NE/4 NE/4 Contr. - Crowe Drlg. Co.

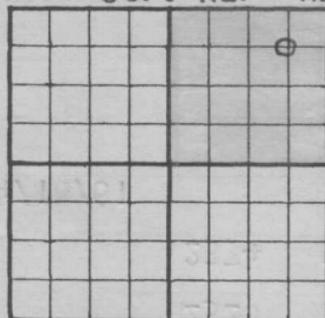

50% - A. A. Seeligson, Jr.
(1/8-AAS, Sr. - 3/8-AAS, Jr.)
25% - Chicago Group
25% - M-R Oil Co.

Subj. to Agreement w/ Lalicker
& Scott dated 1/7/60
2300' Miss. test

TIGHT

NOTE: Show Sketch of Lease and Well Location in Above Space

660 Ft. from N. Line

Ft. from S. Line

Ft. from W. Line 660

Ft. from E. Line

Date	Depth	
9/9/60		Move in Spudder
		8-5/8" @ 200' w/200 sx. cem.,
9/20		M.T.R.T.
9/21	520	Drlg.
9/22	1670	Drlg.
9/23	1955	Drlg. (10'/hr.)
9/25	D.S.T. #1	- 2283-2307 - Op 1 hr., GTS
		in 4", Stab. @ 62,000 cf.,
		Rec. 140' gas-cut mud,

691281

Date	Depth	
		60" gas-cut mdy SW, BHP
		840-790#, FP 60-95#, BHT 87°
		D.S.T. #2 -2307-33' - Op 1 hr., GTS in 30"
		(TSTM), Rec. 140' gcm, 60'
		gcm _{sw} , BHP 820-735#, FP 45-95#
		BHT 86°
	2380	R.T.D.
		4 1/2" @ 2354' w/60 sx. cem.,
		P.D. @ 3:00 p.m. 9/25/60
		WOCT
	<u>Sample Tops:</u>	
	1758	Lansing (-332)
	2281	Miss. "Chat" (-855)
	2328	Miss. Lime (-902)
	2374	Kinderhook (-948)
4/18/61		M.I.C.T. - Ran log,
		Perf. 2282-2302 w/3 ^s ft.,
		Treated w/500 mud acid (no _{sw}
		Frac. 35,000 sd-wtr. treatment
		(Total load - 1305 bbls.)
		Swb. back 150 bbls., little
		gas sho
4/21		Swabbing
4/22		After swbg. 700 bbls. wtr.,
4/26		kicked off & flowed (no rate)
		Completed for 500,000 c _{fg} /d
		Shut in awaiting gas line
		connection 4/26/61