

Marion


DX 78-1

KANSAS

Section 8 Township 19 Range 2E

Well No. #1 Knak

Company Anderson-Prichard.

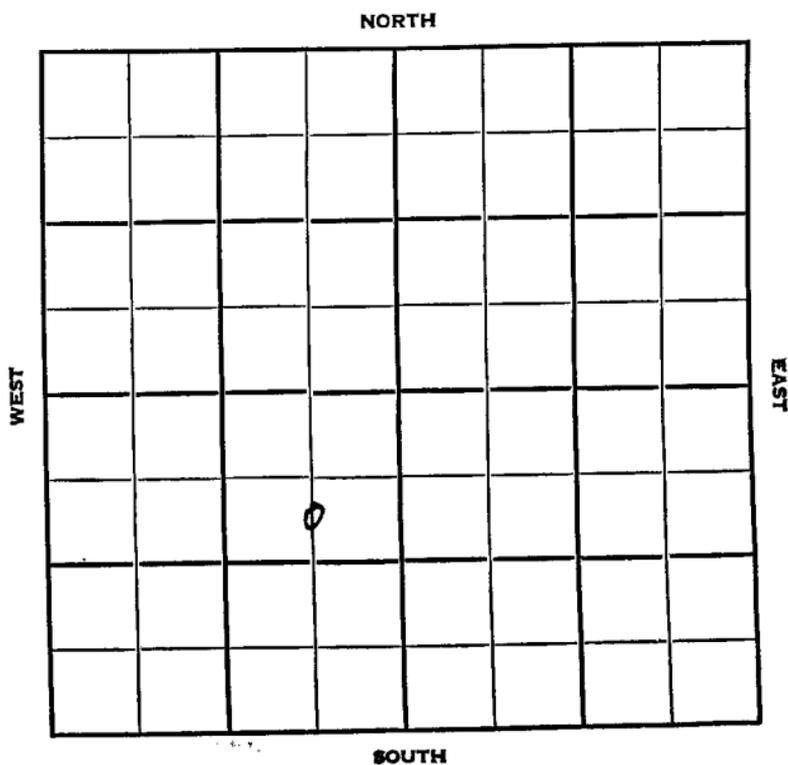

Marion

KANSAS

SEC.	TWP.	R.
8	19	2 E

WELL NO.

1 Knak

FARM

COMPANY

Anderson-Prichard

CONTRACTOR

Peel


Wildcat

990 _____ Ft. from N. Line

_____ Ft. from S. Line

660 _____ Ft. from E. Line

_____ Ft. from W. Line

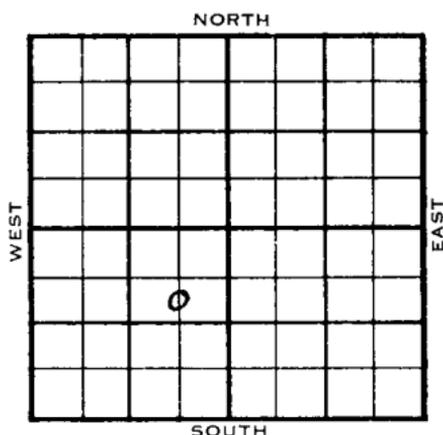C S $\frac{1}{2}$ NE SW

1954

ELEVATION

1477'

REPORT

12/22

Spud 12-19-54

8" @ 150

Drlg. 350'

1955
L/5

Spud 12-19-54

D & A

TD 3289'

8" @ 150'

Lans 2104' Miss 2686'

DST 2692'-2712' opn 2 hr, 13,000 cfg

2 hr. rec 70' Mud, 550# Kh. 2895'

Misener 3131', Viola 3136'

DST 3128'-40' opn 30 min, rec 360'

Muddy sul. wtr. 975# Simp 3206'

DST 3204'-11' opn 1 hr, rec 180' socm
O#DST 3208'-16' opn 2 hr, rec 630' sul.
wtr. 900#DST 3255'-62' opn 2 hr, rec 160' Muddy
sul. wtr. 817# Arb. 3267'

TD 3289'

D & A

APPROVED

County **Marion** State **Kansas**

Sec. **8** (Blk. Twp.) **19** (Sur. Rge.) **2E** Map No.

Operator **Anderson-Prichard**

Well No. **1** Farm **Knak**

Elev. Location **C S $\frac{1}{2}$ NE SW**

990 Ft. From **N** Line **SW**

660 Ft. From **E** Line Quarter

Ist. Report **DEC 22 1954**

Completion

Remarks

Peel - Contr.

Spudding Date **12-19-54**

Drig. Data **Wildcat**

8" @ 150 drlg. 350

FRUIT WINDMILL


County Varion State Kansas

Sec. 8 (Blk. 19 (Sur. 2E (Twp.) Rge.) Map No.

Operator Anderson-Prichard

Well No. 1 Farm Knak

Elev. 1477 Location C S $\frac{1}{2}$ NE SW

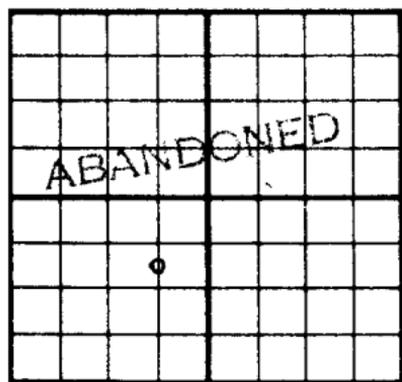

990 Ft. From N Line SW

660 Ft. From E Line Quarter

1st. Report

Completion JAN 5 1955

Remarks Wildcat

Peel - Contr.

Spudding Date 12-19-54

Drig. Data D & A TD 3289

8" @ 150 Lans. 2104 Miss. 2686

DST 2692-2712 open 2 hr. 13,000 cfg

2 hr. Rec. 70' mud 550# Kh. 2895

Misener 3131 Viola 3136 DST 3128-40

open 30 min. Rec. 360' muddy sul. wtr.

975# Simp. 3206 DST 3204-11 open 1 hr

Rec. 180' socm 0# DST 3208-16

open 2 hr. Rec. 630' sul. wtr. 900#

DST 3255-62 open 2 hr. Rec. 160' muddy

sul. wtr. 817# Arb. 3267 TD 3289

D & A

FABER TRAP