

Section 8 Township 19 Range 4-E

Well No. #1 Frank Holub

Company Slausser Drlg. & Alpine Oil & Royalty

NORTH

	0						

WEST

EAST

SOUTH

Sec. 8 Twp. 19 R. H-E ✓

Well No. #1 Frank Holub Farm

Slusser Drlg. & Alpine Oil & Company
Royalty Contractor

Contractor


330 Ft. from N. Line

_____ Ft. from S. Line

_____ Ft. from E. Line

990 Ft. from W. Line

NE NW NW

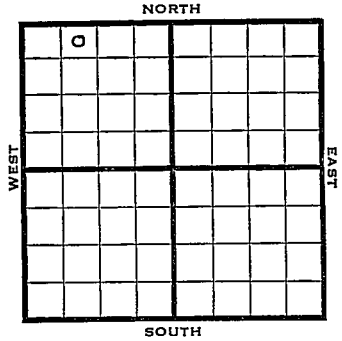

1950

?

REPORT

7/19 Spud 7-16-50
8" @ 113

WOC

8/16 8" @ 113
Miss 2357-59
5" @ 2358
TD 2375
Comp 1 3/4 mcf/gpd
Completed

COMPLETED

Kansas


Map No. _____ Sec. 8 Twp. 19 R. 4E

Well No. 1 Frank Holub

Slusser Drlg. & Alpine OIL Company
 & Royalty
 Contractor

NE NW NW

SECTION PLAT

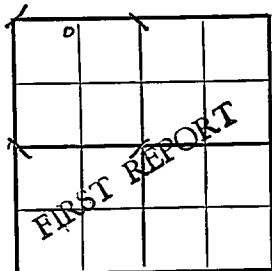

330 Ft. from N. Line
 _____ Ft. from S. Line
 _____ Ft. from E. Line
990 Ft. from W. Line

Marion County

RECORD

Location _____

Cased _____ in., _____ ft.

Rig up _____

Sand _____

Drilling and Remarks:

Gas _____

Spud 7-16-50.

Oil _____

8" @ 113

Total Depth _____

WOC

PRODUCTION

1st 24 hrs. Nat. _____

1st 24 hrs. after shot _____

Gas _____ Cu. Ft.

Dry Hole _____

Abandoned _____

Date

JUL 19 1950

19

J. E. TYRA

Scout

County Marion State Kansas

Sec. 8 (Blk.) 19 (Sur.) 4E Map No. (Twp.) (Rge.)

Operator Slusser Drlg. & Alpine Oil & Royalty

Well No. 1 Farm Frank Holub

Elev. _____ Location NE NW NW

0					

330 Ft. From N Line NW

990 Ft. From W Line Quarter

lst. Report _____

Completion AUG 16 1950

Remarks _____

Spudding Date 7-16-50

Drlg. Data Gas well TD 2375

8" @ 113 Miss. 2357-59 5" @ 2358

TD 2375 Comp. 1 3/4 mcfgpd

J. E. TYRA