


Map No. **KANSAS** Sec. 8 Twp. 19 R. 4^E
 Well No. 1- Propp Farm
General Utility Co Company

645 Ft. from N. Line
~~990~~ Ft. from S. Line
645
~~330~~ Ft. from E. Line
 _____ Ft. from W. Line

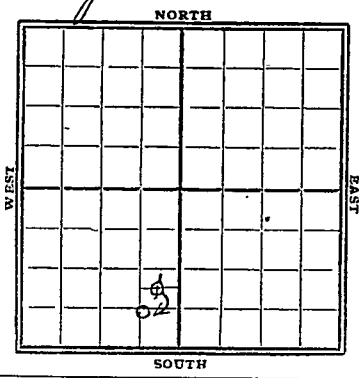

1929

| Date | REPORT |
|------|-------------------|
| 3/6 | Location |
| 3/13 | |
| 3/20 | — |
| 3/27 | — |
| 4/3 | — |
| 4/10 | — |
| 4/17 | — |
| 4/24 | — |
| 5/1 | — |
| 5/8 | Reg |
| 5/15 | — |
| 5/22 | — |
| 5/29 | — |
| 6/5 | — |
| 6/12 | — |
| 6/19 | Regump. |
| 6/26 | — |
| 7/2 | Only at 650' |
| 7/10 | " 1100' |
| 7/17 | " 1500' |
| 7/24 | " 2050' (over) |

7/31- Top chat 2368'
show gas 2370-75'
show oil 2405-10'
1 bailer water 2430-35'
dry 2510'

8/7- HFW-2790-95'
show gas 2368-2400'
T.D. 2795'
Abandoned

Marion

23 **KANSAS** Map No. Sec. 8 Twp. 19 R. 4^E

Well No. 1 *Propo*
General Utility Co Company

Contractor

CORRECTION

SECTION PLAT

..... Ft. from N. Line

645 Ft. from S. Line

645 Ft. from E. Line

..... Ft. from W. Line

| | | | |
|--|--------|--|--|
| | | | |
| | | | |
| | | | |
| | ↓ 0 | | |

Location

Rig up

Drilling and Remarks:

Chg Location

RECORD

Cased..... in., ft.

Sand.....

Gas.....

Oil.....

Total Depth.....

PRODUCTION

1st 24 hrs. Nat.....

1st 24 hrs. after shot.....

Gas..... Cu. Ft.

Dry Hole.....

Abandoned.....

Date

1929

MAY 1

CHAS. L. SHERWOOD

192.....

Scout

Marion

23 **KANSAS** Sec. 8 Twp. 19 R. 4

Well No. 1 *Prop*
General Utility Co Company

Contractor

COMPLETE

SECTION PLAT

_____ Ft. from N. Line

645 Ft. from S. Line

645 Ft. from E. Line

_____ Ft. from W. Line

| | | | |
|--|---|--|--|
| | | | |
| | | | |
| | | | |
| | | | |
| | o | | |

ABANDONED

Location _____

RECORD

Rig up _____

Cased _____ in., _____ ft.

Drilling and Remarks:

Sand _____

NFW 7790-95

Gas _____

Show gas 7368-7400'

Oil _____

Total Depth *2795*

PRODUCTION

1st 24 hrs. Nat. _____

1st 24 hrs. after shot _____

Gas _____ Cu. Ft.

Dry Hole

Abandoned

Date

AUG 7 1929

CHAS. L. SHERWOOD

19

Scout