

Marion

KANSAS


SECTION 8 TOWNSHIP 19S RANGE 4E

WELL NO. #1 Klein

COMPANY Slusser Drlg. SW

NORTH

~~NE~~ NW SW

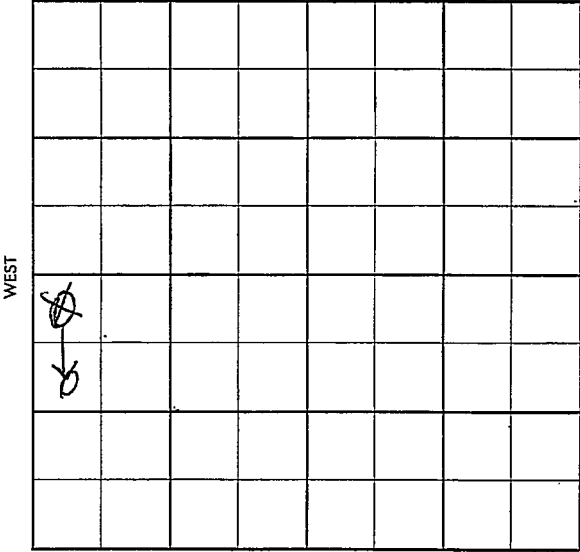

SOUTH



