

DX 78-1

Marion KANSAS


O. W. P. B.

Section 8 Township 19 Range 4E

Well No. 1 Propp Guy "B"

Company H. B. Ratzlaff

NORTH

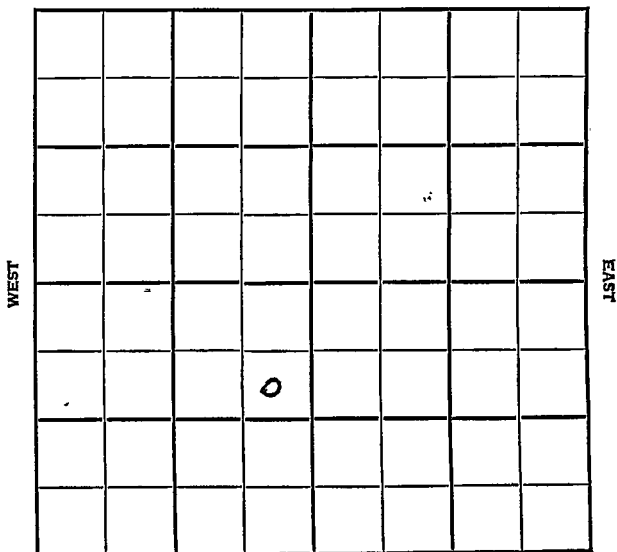


SOUTH

Marion KANSAS

SEC. 8 O. W. P. B. 19 R. 4E  
 WELL NO. 1 Propp Guy "B" FARM  
 COMPANY H. B. Ratzlaff  
 CONTRACTOR Berentz

Propp Pool  
 990 Ft. from N. Line  
 Ft. from S. Line  
 330 Ft. from E. Line  
 Ft. from W. Line

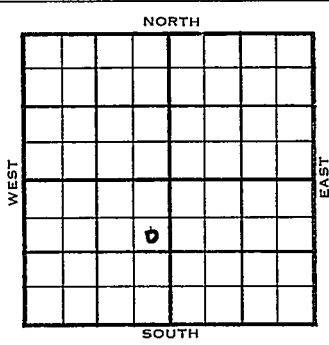

SE NE SW

1954 ELEVATION 1421' REPORT

8/11 8" @ 109'  
 8/25 Spud 8-9-54 - D&A  
 TD 2882'  
 8" @ 109'  
 Br. Lime 1755', Lans 1830', KC 2186',  
 Miss 2365', Miss Lime 2413', Kh. 2502,  
 Chat sh 2699', Misener 2706', Maq.  
 2733', Viola 2758', Simp. dol 2850',  
 Simp.sd 2853'  
 TD 2882'  
 D&A

2733  
 2365  
 368

ABANDONED

1955 O. W. P. B.  
 4/6 Miss 2365' Miss Lime 2413'  
 Viola. 2758', Simp dol. 2850', Simp  
 Sd. 2853'  
 OTD 2882'  
 to CO & set pipe to test Simp  
 & Miss.

OVER

1955  
4/13

D & A TD 2942' Miss 2365'  
Miss lime 2413' Viola 2758'  
Simp. dol. 2850' Simp sd. 2853'  
OTD 2882' Arb. 2904' TD 2942'  
D & A

**ABANDONED**







