

KANSAS

Marion

Form 51-5M-7-40-Palace

Section 8 Township 19 Range 4-E

Well No. #1 Propp Jr.

Company Ben Biggs

NORTH

0							

SOUTH

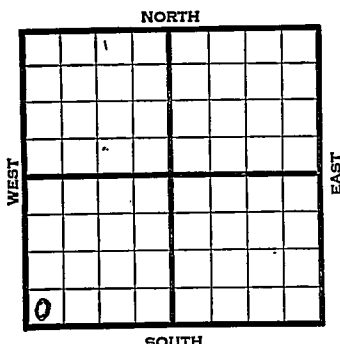
WEST EAST

KANSAS

Marion

Sec. 8 Twp. 19 R. 4-EWell No. #1 Propp Jr. FarmBen Biggs Company

(Lost Spring)

 Ft. from N. Line330 Ft. from S. Line Ft. from E. Line330 Ft. from W. Line

Elev 1399

1941	REPORT
2/12	Drl g. 70'
2/20	15" - 83' Drl g. 12-41-
2/27	SD 175'
3/6	"
3/13	"
3/20	"
3/27	Drl g. 350'
4/2	SD 400'
4/10	Drl g. 660'
4/18	" "
4/24	T.D. 750' Lost hole. Skid rig. 30' west.
5/1	12" - 83' Drl g. 150'
5/8	Drl g. 640'
5/15	SD 640'
5/22	"
5/28	"
6/5	10" - 786' Drl g. 1023'
6/12	SD 1023'
6/19	8" - 1281' Drl g. 1310'
6/26	SD 1310'
	OVER

1941
 7/3 8" - 1351' Drlg. 1377'
 7/10 " "
 7/17 SD-1377'
 7/24 " " "
 7/31 Drlg. 1511'
 8/7 6" @ 1678' Drlg. 1800'
 8/15 " " " "
 8/21 Drlg. 2100'
 8/28 Chat. 2347-48' T.D. Run 5".
 9/4 Shut down.
 9/11 5" - 2347' T.D. 2363'
 46,000 cu. ft. gas.
 9/18 T.D. 2405' in Miss.
 Shut down.
 9/25 " "
 10/2 " "
 10/8 Chat. 2347'
 T.D. 2421'
 No shows.

ABANDONED

Map No. 23 Sec. 8 Twp. 19 R. 4EWell No. 1 Propp Jr.

Ben Biggs

Company

FIRST REPORT

Contractor

SW/C

Ft. from N. Line

330 Ft. from S. Line

Ft. from E. Line

330 Ft. from W. Line**SECTION PLAT**

LOST SPRING POOL

Location _____

Rig up _____

Drilling and Remarks:

Drlg. 70'

RECORD

Cased _____ in., _____ ft.

Sand _____

Gas _____

Oil _____

Total Depth _____

PRODUCTION

1st 24 hrs. Nat. _____

1st 24 hrs. after shot _____

Gas _____ Cu. Ft.

Dry Hole _____

Abandoned _____

Date

FEB 12 1941

19

S. J. LEWIS Scout

Map No. K-23 Sec. 8 Twp. 19 R. 4EWell No. 1 Propp Jr.Ben Biggs

Company

ABANDONED

Contractor

SW/C

 Ft. from N. Line330 Ft. from S. Line Ft. from E. Line330 Ft. from W. Line

SECTION PLAT

0			

LOST SPRING POOL

Location Rig up

Drilling and Remarks:

Cha Y2347Nochowe

RECORD

Cased in., ft.Sand Gas Oil Total Depth 2421

PRODUCTION

1st 24 hrs. Nat. 1st 24 hrs. after shot Gas Cu. Ft.Dry Hole Abandoned

Date

OCT 8 1941 19S. J. LEWIS Scout