
Form 51—5M—7-25—19786

Map No. ~~Kansas~~ Sec. 8 Twp. 19 R. 13 V

Well No. 1 — ~~Fenton~~ Jacob Farm

Double A Oil Company

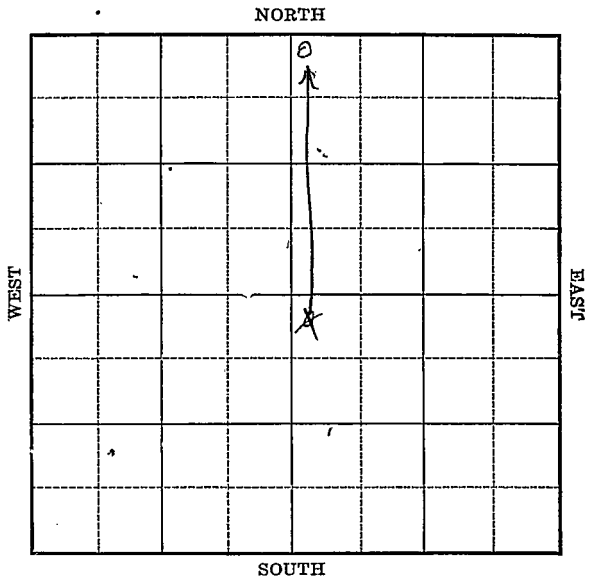

Location

Drilling Remarks

Rig Up

Drilling Remarks

RECORD

Cased in. ft.

Sand

Gas

Oil

Total Depth

PRODUCTION

1st 24 hrs. Nat.

1st 24 hrs. after shot

Gas cu. ft.

Dry Hole

Abandoned

Form 252A—5M—7-25—19684

Lyon Co

Map No. Kansas Sec. 8 Twp. 19 R 13

Well No. 1 ~~Stephens~~ Jacob Farm


Double A O. & G. Company

330 Ft. from N. Line

_____ Ft. from S. Line

_____ Ft. from E. Line

330 Ft. from W. Line

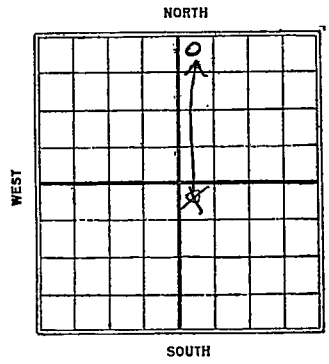

Date 1926	REPORT
3/31	Location
4/7	——
4/15	——
4/21	——
4/28	——
5/8	Same.
5/14	——
5/19	Same.
6/2	Rigging up.
6/10	——
6/18	Rig up & S.D.
6/25	Spudding 2 5-8'
6-30	——
7/8	Dlg 600
7/15	" 1615
7/22	" 1700
7/28	6" 1710' top lime 1800' S.D. 1809
8/11	top lime 1842 - D.& A. 1858 - T.D.

Form 26—1M Bks.—3-23—11959. Lyon

Map No. nemaha KANSAS Sec. 8 Twp. 19 R. 13

Well No. 1 Dez Fnon

Double H Oil & Gas Company

Contractor

FIRST REPORTS


330 Ft. from N. Line

Ft. from S. Line

Ft. from E. Line

330 Ft. from W. Line

SECTION PLAT

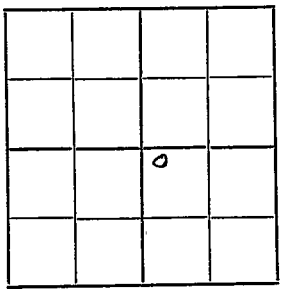

Location ✓

Rig up

Drilling and Remarks:

RECORD

Cased in., ft.

Sand

Gas

Oil

Total Depth

PRODUCTION

1st 24 hrs. Nat.

1st 24 hrs. after shot

Gas Cu. Ft.

Dry Hole

Abandoned

Date

MAR 31 1926

192

CHAS. L. SHERWOOD

Scout

Form 26—1M/Bks.—3-23—11959. Lyon Co

KANSAS

Map No. ____ Sec. 8 Twp. 19 R. 13

Well No. 1 Jacob

Double H Oil Co. Company

____ Contractor

CORRECTION


330 Ft. from N. Line

____ Ft. from S. Line

____ Ft. from E. Line

330 Ft. from W. Line

SECTION PLAT

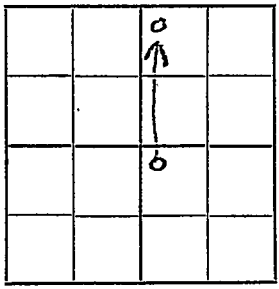

Location ____

Rig up Rig up

Drilling and Remarks:

Chg location
2 Feet North
to above

RECORD

Cased ____ in., ____ ft.

Sand ____

Gas ____

Oil ____

Total Depth ____

PRODUCTION

1st 24 hrs. Nat. ____

1st 24 hrs. after shot ____

Gas ____ Cu. Ft.

Dry Hole ____

Abandoned ____

Date

JUN 2 1926

____ 192____

CHAS. L. SHERWOOD

____ Scout

Form 26—1M Bks. 1-23—11959.

Lyon

Map No. ~~KANSAS~~ Sec. 8 Twp. 19 R. 13

Well No. 1 Jacob

Double H Oil Co.

Company

Contractor

COMPLETED

330 Ft. from N. Line


Ft. from S. Line

Ft. from E. Line

330 Ft. from W. Line

ABANDONED

SECTION PLAT

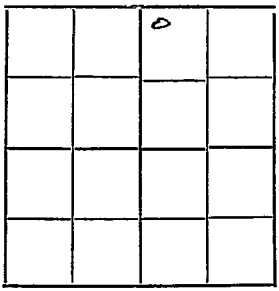

Location

Rig up

Drilling and Remarks:

Top Lime 1842

Dry 1858

RECORD

Cased in., ft.

Sand

Gas

Oil

Total Depth 1858

PRODUCTION

1st 24 hrs. Nat.

1st 24 hrs. after shot

Gas Cu. Ft.

Dry Hole ✓

Abandoned

Date

AUG 11 1926

CHAS. L. SHERWOOD

192

Scout