

State **Kansas** County **Marion**


Company **Messman-Rinehart Oil Co.** Well No. **1**

Farm **Honska**

Survey

Block No. Sec. **8** Twp. **19 S** Range **5 E**

Co-Ord. Elev. **1435' R/B**

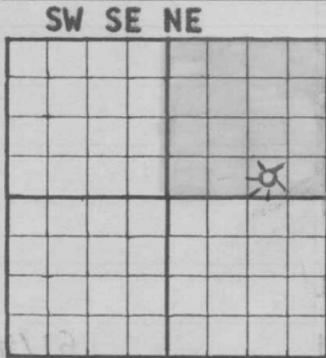

Contr. - Sunflower Drlg  
 43.75% - A. A. Seeligson, Jr.  
 21.875% - Chicago Group  
 21.875% - Messman-Rinehart Oil Co.  
 \*6.25% - Cecil G. Lalicker  
 \*6.25% - Dean C. Scott  
 \* Subj. to Agreement-1/7/60  
 Mrs. Honska - WH 3-3747  
 2300' Miss. test

NOTE: Show Sketch of Lease and Well Location in Above Space

Ft. from N. Line **330** Ft. from S. Line

**990** Ft. from W. Line Ft. from E. Line

Date	Depth	
2-24-61		Location staked
3/10		M.I.R.T.
3/11		Spud - 8-5/8" @ 209 w/200 sx. cem., 4 c.c., P.D. @ 2:30 a.m.
		3/12/61
3/13	800	Drlg.
3/14	1465	Drlg.
	2217	Miss. Chat (-782) 59' chat
3/15	2200	Drlg.
	2276	Miss. Lime (-841)

Date	Depth	691282
3/16	D.S.T. #1	- 2220-80 - Op 1 hr., GTS
	(merc. ga.)	in 2", 10" - ga. 1,140 Mcf
	(merc. ga.)	20" - ga. 1,140 Mcf
	(merc. ga.)	30" - ga. 1,250 Mcf
		Stabilized @ 1,270 Mcf in 40'
		Rec. 130' mud, BHP (30")
		845-815#, FP 310-310'#
		Temp. 85°
3/16	2325	R.T.D.
		4½" @ 2325' w/60 sx. posmix,
		4% gel, P.D. @ 3/16/61
4/18		M.I.C.T. (Ran Log)
4/19		Perf. 2222-42' w/3 <sup>s</sup> ft.,
		Treated w/500 gal. muc acid
		(no swb.), Frac. 35,000# sd-
		wtr. treatment, kicked off
		on first pull, flowed at rate
		of 7,000 Mcfg
4/20 & 4/21		Flowing well
4/22		Completed for 7,000 Mcfg./da.
		Shut in awaiting connection