


Section 9 Township 19 Range 1E

Well No. #1 Vogel

Company J. P. Gaty

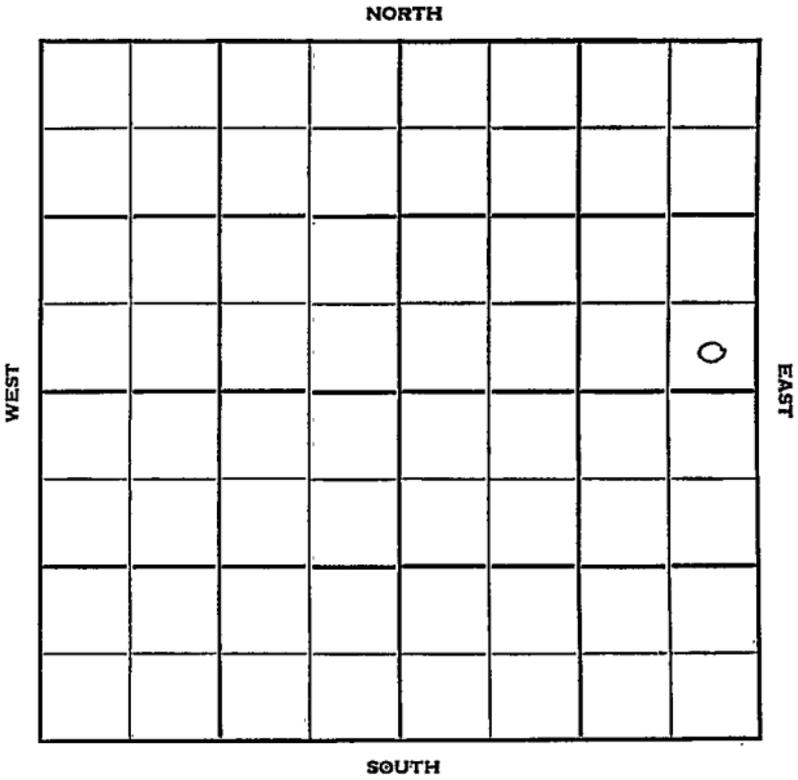

Marion
19

KANSAS
R. 4E

Sec. 9 Twp. _____

Well No. #1 Vogel Farm

J. P. Gaty Company

Slusher - Contr. Contractor
Wildcat


_____ Ft. from N. Line

330' Ft. from S. Line

330' Ft. from E. Line

_____ Ft. from W. Line

SE SE NE

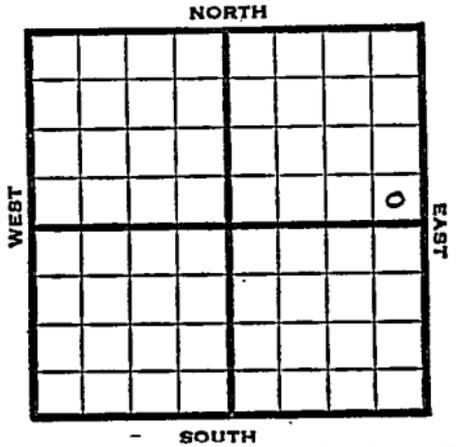

1952

Elev. -


REPORT

2/27
4/2

Cellar & Pits
 D&A TD 2356
 8" @ 105'
 KC 1757 B KC 2105
 Miss. 2290
 5" @ 2311 TD 2356
 FU 75' oil 825' wtr. 10 hr.
 D&A

ABANDONED

County Marion State Kansas
 Sec. 9 (Blk. 19 (Sur. 4E Map No.)
 Operator J. P. Gaty
 Well No. 1 Farm Vogel
 Elev. Location SE SE NE

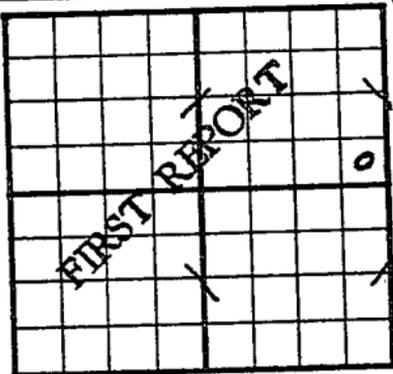

330 Ft. From S Line NE
330 Ft. From E Line Quarter
 Ist. Report FEB 27 1952
 Completion
 Remarks
Slusher - Contr.
 Spudding Date

Drlg. Data Wildcat
Cellar & pits

J. G. McGEHEE


County Marion State Kansas

Sec. 9 (Blk. Twp.) 19 (Sur. Rge.) 4E Map No.

Operator J. P. Gatty

Well No. 1 Farm Vogel

Elev. Location SE SE NE

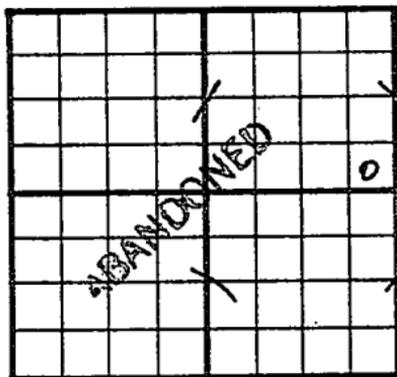

330 Ft. From S Line NE

330 Ft. From E Line Quarter

Ist. Report

Completion APR 2 1952

Remarks Wildcat

Slusser Drlg. - Contr.

Spudding Date

Drlg. Data D & A TD 2356

8" @ 105 KC 1757 B KC 2105

Miss. 2290 5" @ 2311 TD 2356

FU 75' oil 825' water 10 hr.

D & A