

Marion


KANSAS

SECTION 9 TOWNSHIP 19 RANGE ~~##~~ 5E

WELL NO. #1 Jewett

COMPANY Augusta Oil Co.

NORTH

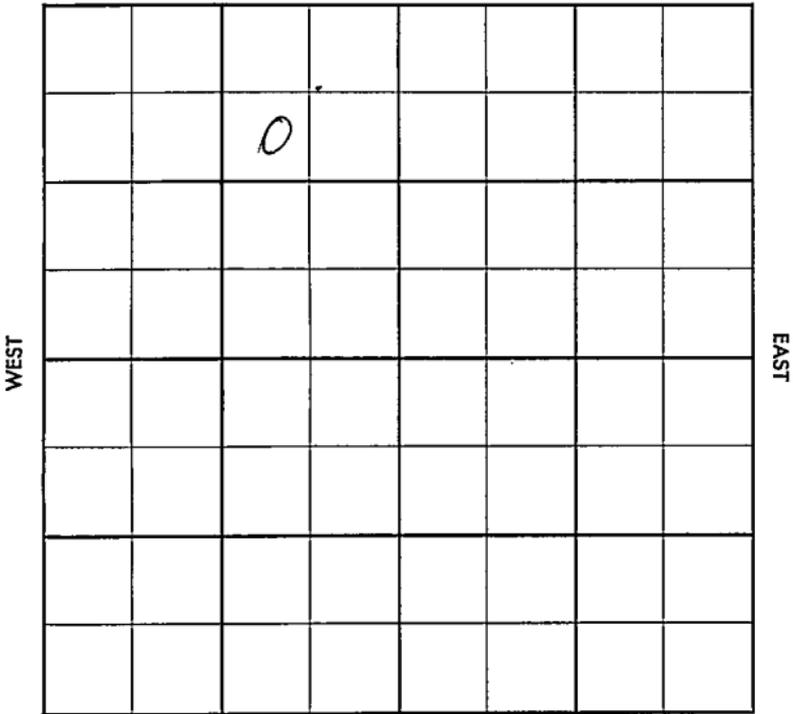

SOUTH

2535
2169
367

FORM 513 SUNRAY

County Marion Elev. _____
 Sec. 9 Twp. 19 Rge. 5E
 Company Augusta Oil Co.
 Farm Name Jewett No. 1

Co.

TOPS	DEPTH	LOG	DATUM
Anh.			
TP.			
H.			
Tr.			
Dg.			
Bl.			
L.			
K.C.	1685		
B.K.C.			
Ce.			
C.			
M.	2168		
M.			
K.			
Mz.			
Ma.			
V.	2535		
S.			
S.			
A.			
R.			
PE.			
G.			
TD.	2555		

Loc. in Sec. SW NE NW
 Geol. _____
 Contr. _____
 Co. Tools _____
 Pool Wildcat

Lse.

~~NO~~
 OCT 17 '56
ABANDONED

No.

Date Comm. 10-5-56
8" @ 225 w/200, Drlg. 1973 G. 17 '56

Sec.

DEA

T.

R.