

15131060080000

KANSAS Nemaha

FORM 51 25M 3-49 PETROL

FORM 252-B
10M 9-49 PETROL

Nemaha

KANSAS

Section 34 Township 1 Range 14-E

Sec. 34 Twp. 1 R. 14E

Well No. #1 Kohler

Well No. #1 Kohler Farm

Company Davon Oil

Davon Oil Company

Contractor

330' Ft. from N. Line



Ft. from S. Line

330' Ft. from E. Line

Ft. from W. Line

NE NE NW

Carter farm out 8 1/2

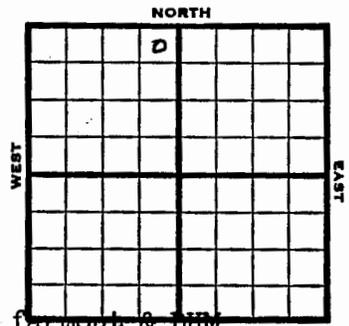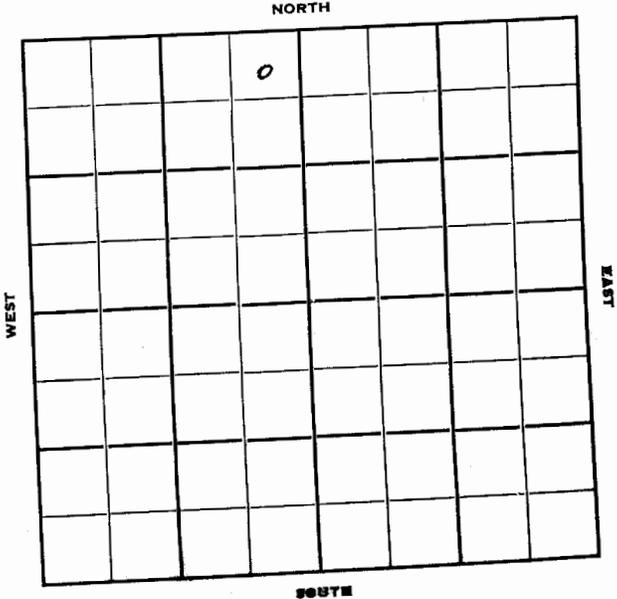

3

1950	Elev 1343'	REPORT
3/1	Location	
3/22	TD 3672'	$\begin{array}{r} 2854 \\ 1343 \\ \hline 1511 \end{array}$
	Topska 920'	
	BKC 1649'	
	Hebner 1164'	
	Miss 2491'	$\begin{array}{r} 2854 \\ 2491 \\ \hline 363 \end{array}$
	Lans 1298'	
	Kinderhook 2617'	
	Hunton 2854'	
	Viola 3605'	
	Aband. D&A	$\begin{array}{r} 1343 \\ 920 \\ \hline 423 \end{array}$
	ABANDONED	
	TOP + 423	$\begin{array}{r} 1343 \\ 1298 \\ \hline 45 \end{array}$
	LEN + 15	
		$\begin{array}{r} 2491 \\ 920 \\ \hline 1571 \end{array}$
		$\begin{array}{r} 2491 \\ 1649 \\ \hline 842 \end{array}$
		$\begin{array}{r} 2491 \\ 1299 \\ \hline 1192 \end{array}$

Kansas

Map No. _____ Sec. 34 Twp. 1 R. 14E

Well No. 1 Kohler


Davon Oil Company

Contractor

NE NE NW

E. 1343

SECTION PLAT

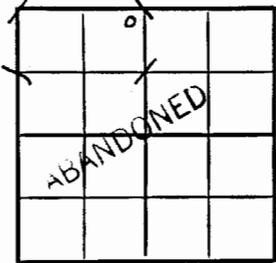

330 Ft. from N. Line

_____ Ft. from S. Line

330 Ft. from E. Line

_____ Ft. from W. Line

Nemaha County

Location _____

Rig up _____

Drilling and Remarks:

Sopaka 920
Hedner 1164
Lans. 1298
BKC 1649
Mine 2491
Kirkland 2617
Hunter 2854
Uida 3605
T.D. 3672

RECORD

Cased _____ in., _____ ft.
Sand _____
Gas _____
Oil _____
Total Depth _____

PRODUCTION

1st 24 hrs. Nat. _____
1st 24 hrs. after shot _____
Gas _____ Cu. Ft.
Dry Hole _____
Abandoned _____

D+A

Date

MAR 22 1950 19 J. E. TYRA Scout

Kansas

Map No. _____ Sec. 34 Twp. 1 R. 14E

Well No. 1 Kohler

Davon Oil Company

Contractor

NE NE NW

SECTION PLAT



330 Ft. from N. Line

_____ Ft. from S. Line

330 Ft. from E. Line

_____ Ft. from W. Line

Nemaha County

Cartter farmout & DDM

Location X _____

Rig up _____

Drilling and Remarks:

RECORD

Cased _____ in., _____ ft.
Sand _____
Gas _____
Oil _____
Total Depth _____

PRODUCTION

1st 24 hrs. Nat. _____
1st 24 hrs. after shot _____
Gas _____ Cu. Ft.
Dry Hole _____
Abandoned _____

Date

MAR 1 1950 19 J. E. TYRA Scout

Scout Cards	Smith
Land Small Map	
Land Wall Map	5
Tracings	
Misc.	

MAR 30 1950

Scout Cards	Smith
Land Small Map	
Land Wall Map	5
Tracings	
Misc.	

MAR 3 1950