


KANSAS Brown County

FORM 51 5M PETROL

Section 10 Township 1 Range 15E

Well No. 1 Meisly

Company ~~Clifton Gall etal~~ P. S. Tomer etal

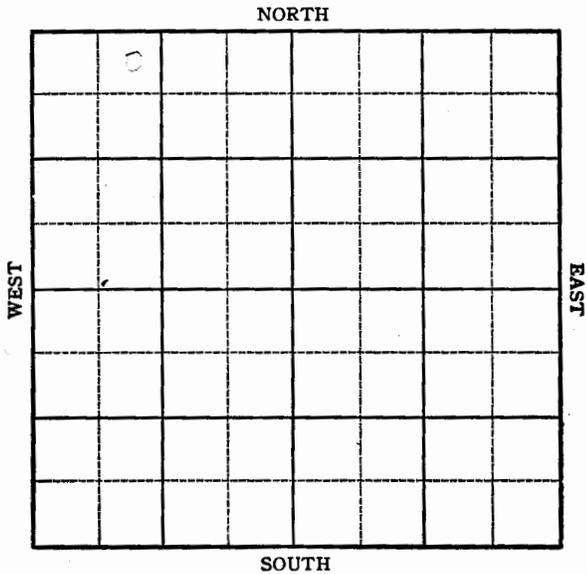

4

FORM 252 A
5M 3-45 PETROL

KANSAS

Brown

Sec. 10 Twp. 1 R. 15E

Well No. 1 Meisly Farm

~~Clifton Gall etal~~ P. S. Tomer etal Company


Livingood
330 Ft. from N. Line

_____ Ft. from S. Line

_____ Ft. from E. Line

990 Ft. from W. Line

NE NW NW

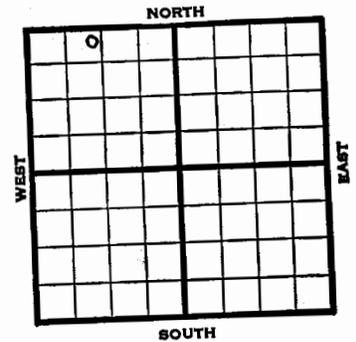

1945

Elev. 1139

REPORT

5/9 Location
5/17 Drlg. 1790
5/24 Drlg. 2567
5/31 Hunton 2656
TD 2662 SO
5" @ 2658' RUST
6/8/45 " " "
6/14 " " "
6/21 Drlg. 2721
6/28 " "
7/11 Hunton 2656
5" @ 2658
TD 2721'

ABANDONED

Kansas Pool Name Livingood

Map No. 149 Sec. 10 Twp. 1 R. 15E

Well No. 1 Meisly

R S Tomer etal Company

CORRECTION Contractor

NE NW NW


SECTION PLAT

333 Ft. from N. Line

_____ Ft. from S. Line

_____ Ft. from E. Line

990 Ft. from W. Line

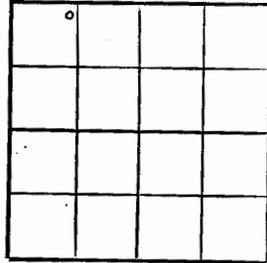

Brown

Location _____

Rig up _____

Drilling and Remarks:
reported

Clifton Gall etal

RECORD

Cased _____ in., _____ ft.

Sand _____

Gas _____

Oil _____

Total Depth _____

PRODUCTION

1st 24 hrs. Nat. _____

1st 24 hrs. after shot _____

Gas _____ Cu. Ft.

Dry Hole _____

Abandoned _____

Date

MAY 29 1945 19

S. J. LEWIS Scout

KANSAS Pool Name Livingood

Map No. 149 Sec. 10 Twp. 1 R. 15E

Well No. 1 Meisly

R. S. Tomer etal Company

ABANDONED Contractor

NE NW NW


E11139
SECTION PLAT

330 Ft. from N. Line

_____ Ft. from S. Line

_____ Ft. from E. Line

990 Ft. from W. Line

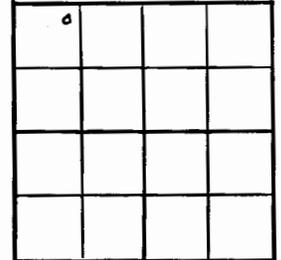

Brown County

Location _____

Rig up _____

Drilling and Remarks:

Hutton 2656
5' @ 2658

RECORD

Cased _____ in., _____ ft.

Sand _____

Gas _____

Oil _____

Total Depth 2721

PRODUCTION

1st 24 hrs. Nat. _____

1st 24 hrs. after shot _____

Gas _____ Cu. Ft.

Dry Hole _____

Abandoned _____

Date

JUL 11 1945 19

S. J. LEWIS Scout

no wall

Misc Small Maps	
Cards	<i>RB</i>
Tracing	<i>RB</i>
France Map	<i>✓</i>
Scarborough Map	<i>✓</i>
Pierce Map	<i>✓</i>
Geolo	
Plans	

Misc Small Maps	<i>RB</i>
Cards	<i>RB</i>
Tracing	<i>RB</i>
France Map	<i>✓</i>
Scarborough Map	<i>✓</i>
Misc Small Maps	
Geolo	
Plans	

no wall

Kansas Pool Name Livingood

Map No. K-149 Sec. 10 Twp. 1 R. 15E

Well No. 1 Meisly

Clifton-Gall etal Company

FIRST REPORT Contractor
NE NW NW


SECTION PLAT

330 Ft. from N. Line

_____ Ft. from S. Line

_____ Ft. from E. Line

990 Ft. from W. Line

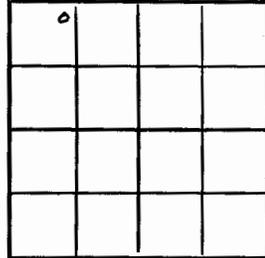

Brown County

Location X

Rig up _____

Drilling and Remarks:

RECORD

Cased _____ in., _____ ft.

Sand _____

Gas _____

Oil _____

Total Depth _____

PRODUCTION

1st 24 hrs. Nat. _____

1st 24 hrs. after shot _____

Gas _____ Cu. Ft.

Dry Hole _____

Abandoned _____

Date

MAY 9 1945

S. J. LEWIS Scout

Small

File Snail Maps	_____
Cards	<i>BB</i>
Tracing	<i>BB</i>
France Map	_____
Scarborough Map	_____
Pierce Map	_____
Geological Dept.	_____
Pierce Plot Book	_____