
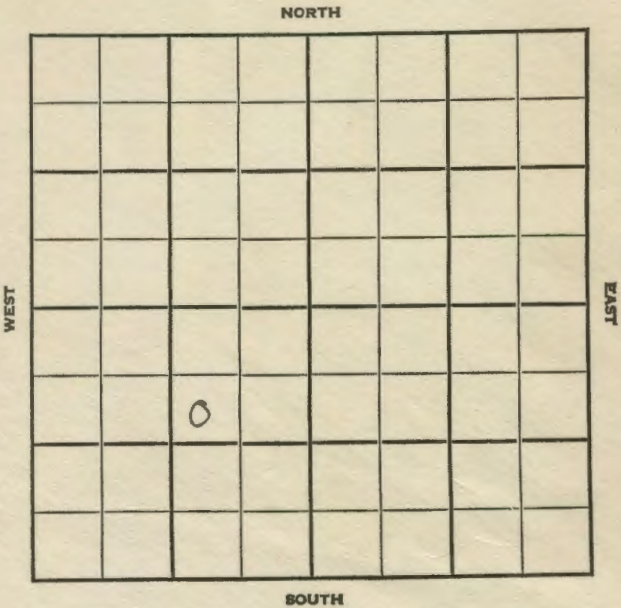


Section 3 Township 1 Range 15E
Well No. 1 Livengood
Company Stout & Hahn

Sec. 3 Twp. 1 R. 15E

Well No. #1 Livengood Farm
Stout & Hahn Company

Livengood
990 Ft. from N. Line
Ft. from S. Line
990 Ft. from E. Line
Ft. from W. Line
SW NE SW

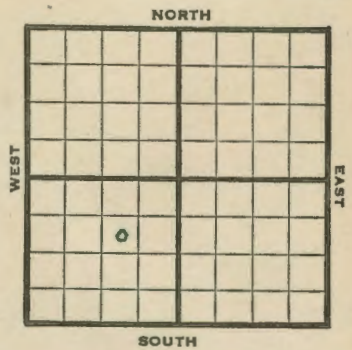

//

Date	Log Description	Notes
1947	Elev. 1083'	REPORT
12/30	8" @ 60' Miss. 2224' Drlg. 2338'	
1948 1/7	"	2605 1083 1522
1/14	Hunton 2605 TD 2607½ 5" @ 2606 RUST	
1/21	"	
1/26	TD 2608' Swb 10 bbls fluid PH 4 hrs 50% water oil 27.0 Gr.	
2/4	"	
2/11	3000 acid Swab 35 bbls. fluid PH 8 hrs. 50% wtr.	
2/18	" "	
2/25	" "	
3/3	Hunton 2605' 5" @ 2606' 3000 Acid Pump 40 oil / 300 W Pot Gr. 24° Total Depth 2610' COMPLETED	

Map No. 149 Sec. 3 Twp. 1 R. 15E

Well No. 1 Livengood

Stout & Hahn Company

COMPLETE

Contractor

SW NE SW

El. 1085
SECTION PLAT

990 Ft. from N. Line

_____ Ft. from S. Line

990 Ft. from E. Line

_____ Ft. from W. Line

Brown County

Location _____

Rig up _____

Drilling and Remarks:

Hunter 2605

5" @ 2606

80000 cu ft

Pump 4000 ft 7300 ft

2428

RECORD

Cased _____ in., _____ ft.

Sand _____

Gas _____

Oil

Total Depth 2610

PRODUCTION

1st 24 hrs. Nat. _____

1st 24 hrs. after shot _____

Gas _____ Cu. Ft.

Dry Hole _____

Abandoned _____

Date

MAR 3 1948 19 S. J. LEWIS Scout

Map No. _____ Sec. 3 Twp. 1 R. 15E

Well No. 1 Livengood

Stout & Hahn Company

FIRST REPORT

Contractor

SW NE SW

SECTION PLAT

990 Ft. from N. Line

_____ Ft. from S. Line

990 Ft. from E. Line

_____ Ft. from W. Line

Brown County

Location _____

Rig up _____

Drilling and Remarks:

8" @ 60

Miss. 2224

drlg. 2338

RECORD

Cased _____ in., _____ ft.

Sand _____

Gas _____

Oil _____

Total Depth _____

PRODUCTION

1st 24 hrs. Nat. _____

1st 24 hrs. after shot _____

Gas _____ Cu. Ft.

Dry Hole _____

Abandoned _____

Date

DEC 30 1947 19 S. J. LEWIS Scout