


Section 3 Township 1 Range 15E

Well No. 1 Livingood "A"

Company R. S. Tomer Prod.

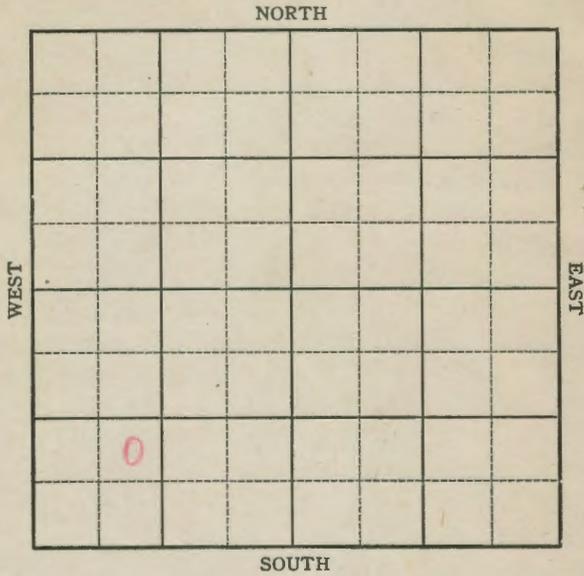

Sec. 3 Twp. 1S R. 15E

Well No. #1 Livingood "A" Farm

R. S. TOMER PROD. Company


Wildcat

_____ Ft. from N. Line

990 Ft. from S. Line

_____ Ft. from E. Line

990 Ft. from W. Line

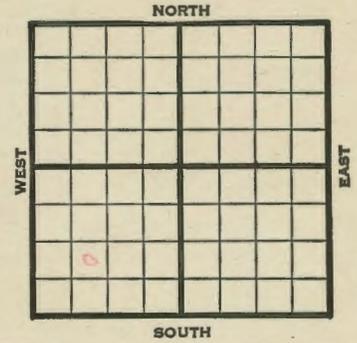

NE SW SW

REPORT

1945

Elev. 1113

4-18

8" at 60'
Drilling 780'

4/26

Drlg. 1775'

5/3

Hunton 2617 !

TD 2631' SSO

5" @ 2628' RUST

" " " "

5/10

TD 2633

5/17

1000 acid. Swb. 10 fluid PH

5/24

" " " " " "

5/31

" " " " " "

5/8/45

" " " " " "

6/20

Hunton 2617

5" @ 2628

TD 2633

1000 acid.

Pump 80 oil plus 80 W. Pot.

Grav. 28.0

COMPLETED.

13

Kansas Pool Name Wildcat

Map No. 149 Sec. 3 Twp. 1 R. 15E

Well No. 1 Livingood "A"

R. S. Tomer Prod. Company

FIRST REPORT Contractor


NE SW SW SECTION PLAT

_____ Ft. from N. Line

990 Ft. from S. Line

_____ Ft. from E. Line

990 Ft. from W. Line

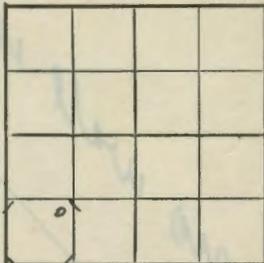

rown

Location _____

RECORD

Cased _____ in., _____ ft.

Sand _____

Gas _____

Oil _____

Total Depth _____

PRODUCTION

1st 24 hrs. Nat. _____

1st 24 hrs. after shot _____

Gas _____ Cu. Ft.

Dry Hole _____

Abandoned _____

Date

APR 18 1945 19 S. J. LEWIS Scout

Kansas Pool Name Livingood

Map No. _____ Sec. 3 Twp. 1 R. 15E

Well No. 1 Livingood "A"

R. S. Tomer Prod. Company

COMPLETED Contractor


NE SW SW SECTION PLAT

_____ Ft. from N. Line

990 Ft. from S. Line

_____ Ft. from E. Line

990 Ft. from W. Line

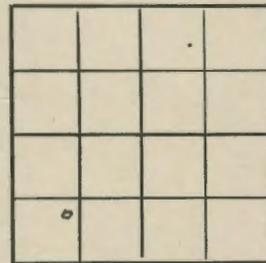

Brown County

Location _____

RECORD

Cased _____ in., _____ ft.

Sand _____

Gas _____

Oil _____

Total Depth 2633

PRODUCTION

1st 24 hrs. Nat. _____

1st 24 hrs. after shot _____

Gas _____ Cu. Ft.

Dry Hole _____

Abandoned _____

Date

JUN 20 1945 19 S. J. LEWIS Scout

*Houston 2617
5" C2 & 28
1000 acid
Pump 8000 ft
S.W.P.T.*

28° Gr