


Section 4 Township 1 Range 15 E

Well No. #1 Livengood

Company Smith & Houston

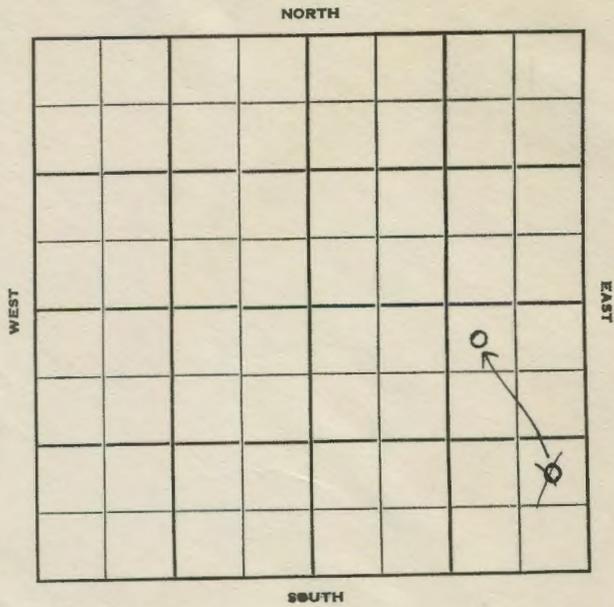

9

Sec. 4 Twp. 1 R. 15E

Well No. #1 Livengood Farm

Smith & Houston Company

Brown & Tomer - Contr. Contractor

Livengood Pool


330 Ft. from N. Line

~~990~~ Ft. from S. Line

990
~~330~~ Ft. from E. Line

Ft. from W. Line

~~NE SE SE~~
NW NE SE

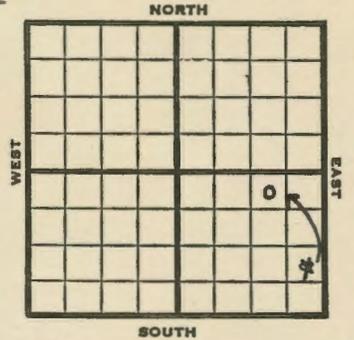

1951 **Elev. 1135'** REPORT

1/31 RUR

5/23 Oil well TD 2649'
Miss 2283', Hunton 2642', TD 2649'
5" @ 2643 S/24 BO 56 BWPD
Comp. 15 BOPD lots of water

COMPLETED

2642
2283
359

Kansas

Map No. _____ Sec. 4 Twp. 1 R. 15E

Well No. 1 Livengood

Smith & Houston Company

~~CORRECTION~~ Contractor

NW NE SE


SECTION PLAT

330 Ft. from N. Line

_____ Ft. from S. Line

990 Ft. from E. Line

_____ Ft. from W. Line

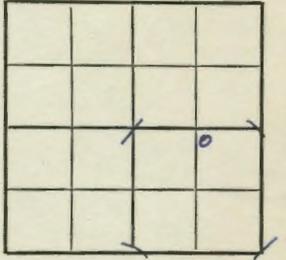

Brown County

Location _____

Rig up _____

Drilling and Remarks:

Reported

NE SE SE

RECORD

Cased _____ in., _____ ft.

Sand _____

Gas _____

Oil _____

Total Depth _____

PRODUCTION

1st 24 hrs. Nat. _____

1st 24 hrs. after shot _____

Gas _____ Cu. Ft.

Dry Hole _____

Abandoned _____

Date

FEB 21 1951

19

J. E. TYRA Scout