

KANSAS

Brown County


FORM 51 5M PETROL

Section 4 Township 1 Range 15E

Well No. 1 Warner

Company R. S. Tomer etal

NORTH

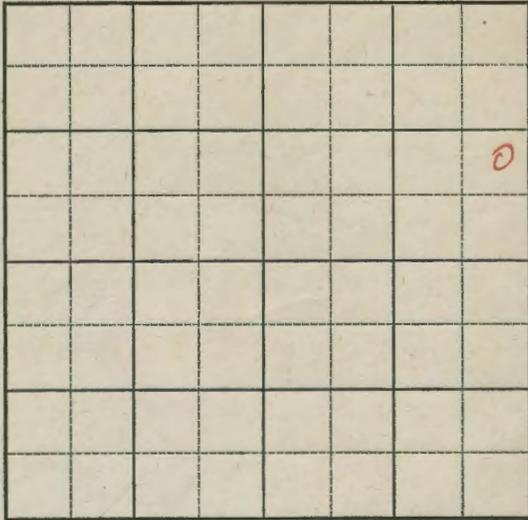

SOUTH

5M 3-45 PETROL

KANSAS

Brown County

Sec 4 Twp 1 R. 15E

Well No. 1 Warner Farm

R. S. Tomer etal Company

Livingood


Ft. from N. Line

990 Ft. from S. Line

330 Ft. from E. Line

Ft. from W. Line

NORTH

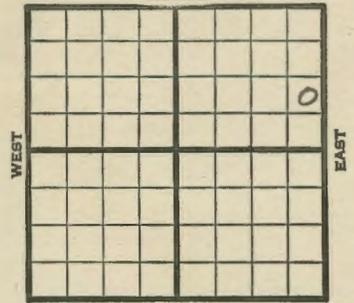

SOUTH

NE SE NE

1945 **Elev. 1143** REPORT

6/27 8" @ 130'
1320'

7/3 Drlg. 1800D

7/11 Miss 2292

B Miss 2378

Hunton 2650

Drlg. 2661'

7/19 " " "

7/26 " " "

8/1 " " "

8/8 " " "

8/15 " " "

8/22 Kind 2663

Hunton 2650

5" @ 2645

TD 2698'

2650
2292
258

ABANDONED

8

KANSAS

Kansas Pool Name Livingood

Map No. 149 Sec. 4 Twp. 1 R. 15E

Well No. 1 Warner

R. S. Tomer etal Company

ABANDONED

Contractor

NE SE NE


E. 11/143
SECTION PLAT

 Ft. from N. Line

990 Ft. from S. Line

330 Ft. from E. Line

 Ft. from W. Line

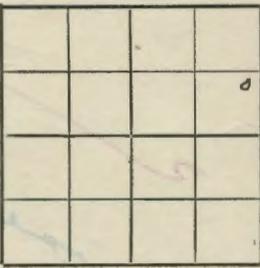

Brown County

Location

Rig up

Drilling and Remarks:

*Kind 2663
Hun ton 2650
5" @ 2645*

RECORD

Cased in., ft.

Sand

Gas

Oil

Total Depth 2695

PRODUCTION

1st 24 hrs. Nat.

1st 24 hrs. after shot

Gas Cu. Ft.

Dry Hole

Abandoned

Date

AUG 22 1945 19

S. J. LEWIS Scout

Kansas Pool Name Livingood

Map No. 149 Sec. 4 Twp. 1 R. 15E

Well No. 1 Warner

R. S. Tomer etal Company

FIRST REPORT

Contractor

NE SE NE


SECTION PLAT

 Ft. from N. Line

990 Ft. from S. Line

330 Ft. from E. Line

 Ft. from W. Line

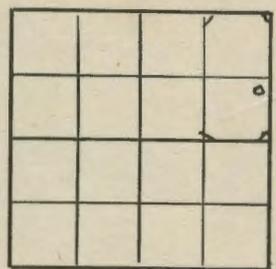

Brown County

Location

Rig up

Drilling and Remarks:

*8"-130
1320*

RECORD

Cased in., ft.

Sand

Gas

Oil

Total Depth

PRODUCTION

1st 24 hrs. Nat.

1st 24 hrs. after shot

Gas Cu. Ft.

Dry Hole

Abandoned

Date

JUN 27 1945 19

S. J. LEWIS Scout