


KANSAS

Section 10 Township 1 Range 17E

Well No. #1 Babcock

Company Palensky Bros.

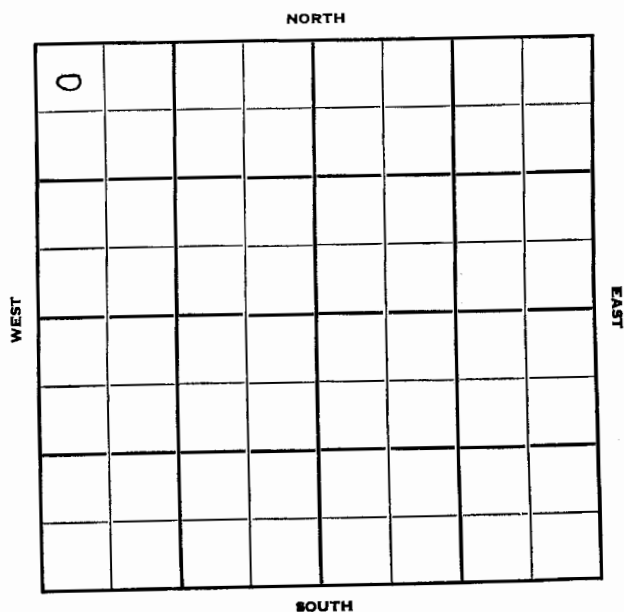

KANSAS

Sec. 10 Twp. 1 R. 17E

Well No. #1 Babcock

Palensky Bros. Company

Stout Drlg. Contractor

Wildcat


330 Ft. from N. Line

Ft. from S. Line

Ft. from E. Line

330 Ft. from W. Line

NW NW NW

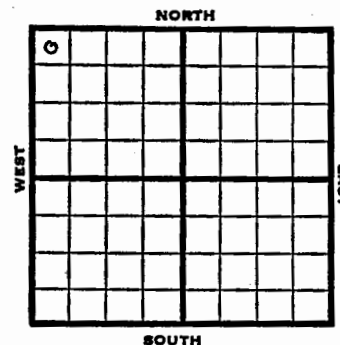

1952 Elev. 1008' REPORT

10/8 RUR
11/5 Spud 10-9-52
D&A TD 2600'
8" @ 83'
KC 805
Miss. 2163
Hunton 2580
TD 2600' D&A

B KC 1108
B. Miss. 2334

ABANDONED

2580
2163
617

County **Brown** State **Kansas**

Sec. **10** (Blk. Twp.) **1** (Sur. Rge.) **17E** Map No.

Operator **Palensky Bros.**

Well No. **1** Farm **Babcock**

Elev. Location **NW NW NW**

0									

330 Ft. From **N** Line **NW**

330 Ft. From **W** Line Quarter

1st. Report **OCT 8 1952**

Completion

Remarks **Stout Drlg. - Contr.**

Spudding Date

Drlg. Data **Wildcat****RUR**

J. G. McGEHEE

County **Brown** State **Kansas**

Sec. **10** (Blk. Twp.) **1** (Sur. Rge.) **17E** Map No.

Operator **Palensky Bros.**

Well No. **1** Farm **Babcock**

Elev. **1008** Location **NW NW NW**

0									

330 Ft. From **N** Line **NW**

330 Ft. From **W** Line Quarter

1st. Report

Completion **NOV 5 1952**

Remarks **Wildcat**

Stout Drlg. - Contr.

Spudding Date **10-9-52**

Drlg. Data **D & A TD 2600****8" @ 83 KC 805 B KC 1108 Miss. 2163****B. Miss. 2334 Hunton 2580 TD 2600****D & A****2163****1008****1150**

J. G. McGEHEE

Scout Cards	
Land Map	
Land Wall Map	
Tracings	
France Map	
Pierce Map	
Misc.	

NOV 12 1952

Orig. Data

Scout Cards	
Land Map	
Land Wall Map	
Tracings	
France Map	
Pierce Map	
Misc.	

OCT 13 1952

Orig. Data