

151170030000


Marshall

KANSAS

SECTION 19 TOWNSHIP 1 RANGE 9E

WELL NO. #1 Ringen

COMPANY H. & L. Cil Co. (Omaha, Nebr.)

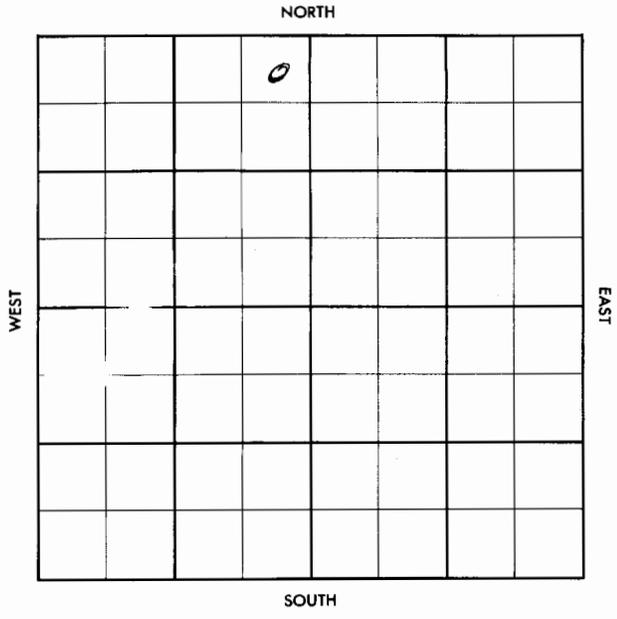

3

FORM 513 SUNRAY

No County Map

County Marshall Elev. _____
 Sec. 19 Twp. 1 Rge. 9E
 Company H. & L. Oil Co. (Omaha Neb)
 FarmName Ringen No. 1

TOPS	DEPTH	LOG	DATUM	Loc. in Sec.
Anh.				NE NE NW
Tr.				
H.				
Tr.				
Dg.				
Bl.				
L.				
K.C.				Geol.
B.K.C.				Contr.
Ce.				Stout Drlg.
C.				
M.				Pool
M.				Wildcat
K.				
Mz.				
Me.				
V.				
S.				
A.				
R.				
Pe.				
G.				

Date Comm. _____
 Location 2200' 1st. _____

FORM 513 SUNRAY

E1 1375

(No County Map)

County Marshall Elev. _____
 Sec. 19 Twp. 1 Rge. 9E
 Company H. & L. Oil Co. (Omaha Neb)
 FarmName Ringen No. 1

TOPS	DEPTH	LOG	DATUM	Loc. in Sec.
Tr.	700			NE NE NW
H.	880			
Tr.				
Dg.				
Bl.				
L.	1015			
K.C.				Geol.
B.K.C.	1460			Contr.
Ce.				Stout Drlg.
C.				
M.				Pool
M.				Wildcat
K.				
Mz.				
Me.	1620	1680		
V.	1625	1460		
S.	1970			
A.	29-57 Act 2080			
R.				
Pe.		1460		
G.	2110	1315		ABANDONE
G.	2115	45		
G.	2116	2290		

Date Comm. _____
 Location 2200' 1st. OCT 3 '56 9-30-56
278 62 150 D 165 Tite
46.01 130 D 1403 OCT 17 '56 OCT 24 '56 OCT 31
NOV 7 '56 NOV 13 '56 NOV 21 '56 NOV 28 '56 TOP
DEC 5 '56 DEC 12 '56 S.P. DEC 19 '56 DEC 26 '56
JAN 2 '57
D&O
RECEIVED