


Map No. Kansas Sec. 1 Twp. 20 R. 14 ✓Well No. 1 Davis FarmBucher Etal. Company

NORTH

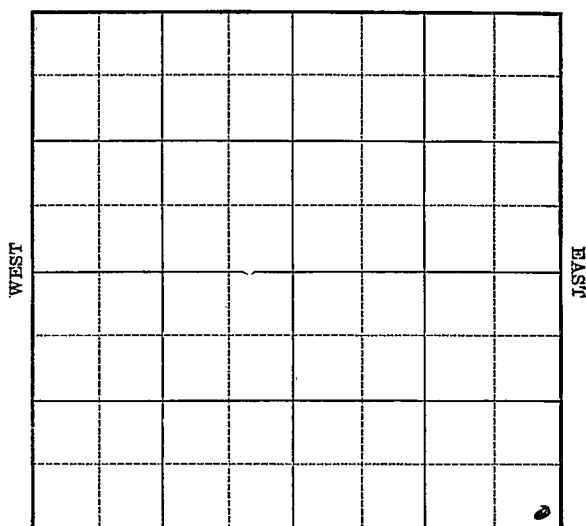

SOUTH

Location _____

Drilling Remarks _____

Rig Up _____

Drilling Remarks _____

RECORD

Cased _____ in. _____ ft.

Sand _____

Gas _____

Oil _____

Total Depth _____

PRODUCTION

1st 24 hrs. Nat. _____

1st 24 hrs. after shot _____

Gas _____ cu. ft.

Dry Hole _____

Abandoned _____

Coffey

Map No. Kansas Sec. 1 Twp. 20 R. 14Well No. 1 Davis FarmBucher et al Company

NORTH


_____ Ft. from N. Line

200 Ft. from S. Line200 Ft. from E. Line

_____ Ft. from W. Line

WEST

EAST

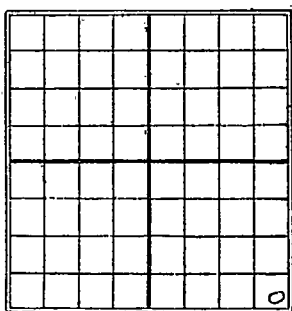

SOUTH

Date
1926

REPORT

3/25 Spudding

4/1 _____

4/7 _____

4/14 S.D. 550

4/21 Alg 750

4/28 " 750

5/5 J.D. 1760. Top line
1710 D. a. 1760

Copper
20
 KANSAS Sec. *1* Twp. *20* R. *14*
 Map No. *1*
 Well No. *Davis*
Bucher & Co Company

Contractor

FIRST REPORTS

Ft. from N. Line

200

Ft. from S. Line

200

Ft. from E. Line

Ft. from W. Line

SECTION PLAT

Location

Rig up

Drilling and Remarks:

Spudding

RECORD

Cased _____ in., _____ ft.

Sand _____

Gas _____

Oil _____

Total Depth _____

PRODUCTION

1st 24 hrs. Nat. _____

1st 24 hrs. after shot _____

Gas _____ Cu. Ft.

Dry Hole _____

Abandoned _____

Date

MAR 25 1926

CHAS. L. SHERWOOD

192

Scout

AD map
 Map No. **KANSAS** Sec. **1** Twp. **20** R. **14**
 Well No. **11 Davis**
Duckon et al Company

Contractor

COMPLETED

SECTION PLAT

Ft. from N. Line

200

Ft. from S. Line

300

Ft. from E. Line

Ft. from W. Line

			6

ABANDONED

Location

Rig up

Drilling and Remarks:

Zap line 1710

D Q 4

1760

RECORD

Cased _____ in., _____ ft.

Sand _____

Gas _____

Oil _____

Total Depth 1766

PRODUCTION

1st 24 hrs. Nat. _____

1st 24 hrs. after shot _____

Gas _____ Cu. Ft.

Dry Hole ☒Abandoned ☒

Date

MAY 5 1926

CHAS. L. SHERWOOD

192

Scout