


Marion KANSAS

Section 11 Township 20 Range 3 E

Well No. # 1 Siebert

Company Mendenhall Drlg.

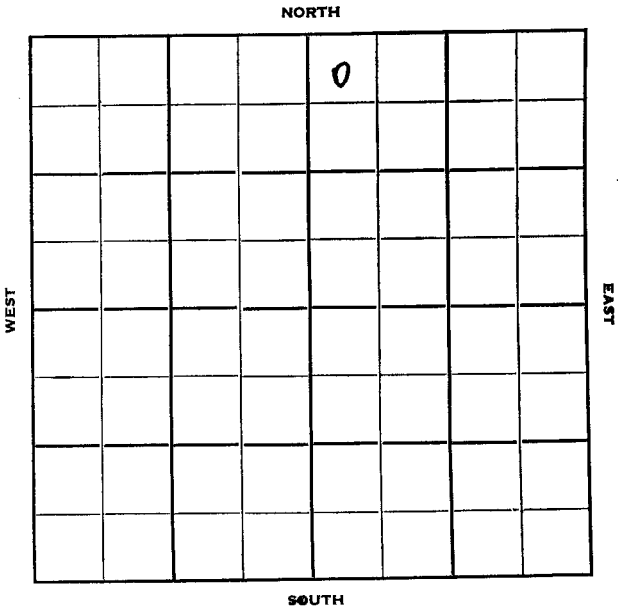

Marion

KANSAS ✓

Sec. 11 Twp. 20 R. 3EWell No. #1 Siebert FarmMendenhall Drlg. Company

Contractor


Wildcat.330 Ft. from N. Line

Ft. from S. Line

Ft. from E. Line

330 Ft. from W. Line

NW NW NE

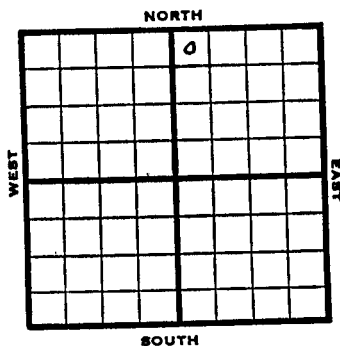

1953 Elev. 1347' REPORT

6/24 Loc.

7/22 Spud 6-27-53

D&A

TD 2706

8" @ 110

ans 1778, Marm 2158, Miss 2 329,
Kh. 2400, hat 2536, Maq 2571, Viola
2603, Simp 2679DST 2340-2400, opn 1 hr., rec. 40' mud
30#DST 2604-13, opn 40 mins, rec. 575'
wtr, 890#

TD 2706

D&A

ABANDONED

County **Marion** State **Kansas**
 Sec. **11** (Blk.) **20** (Sur.) **3E** Map No.
 Operator **Mendenhall Drlg.**
 Well No. **1** Farm **Siebert**
 Elev. Location **NW NW NE**

FIRST REPORT

330 Ft. From **N** Line **NE**
330 Ft. From **W** Line Quarter
 1st. Report **JUN 24 1953**
 Completion
 Remarks
 Spudding Date

Drlg. Data

Wildcat**Location**

County Marion State Kansas
 Sec. 11 (Blk.) 20 (Sur.) 3E Map No.
 Operator Mendenhall Drlg.
 Well No. 1 Farm Siebert
 Elev. 1347 Location NW NW NE

			0		

330 Ft. From N Line NE
330 Ft. From W Line Quarter
 1st. Report
 Completion JUL 22 1953
 Remarks Wildcat

Spudding Date 6-27-53

Drlg. Data D & A TD 2706
8" @ 110 Lans. 1778 Marm. 2158
Miss. 2329 Kh. 2400 Chat 2536
Maq. 2571 Viola 2603 Simp. 2679
DST 2340-2400 open 1 hr. Rec. 40' mud
30# DST 2604-13 open 40 min.
Rec. 575' wtr 890# TD 2706

D & A