


Section 8 Township 20 Range 12 EWell No. 1 BlairCompany Lance Hill & B & R Drlg

NORTH

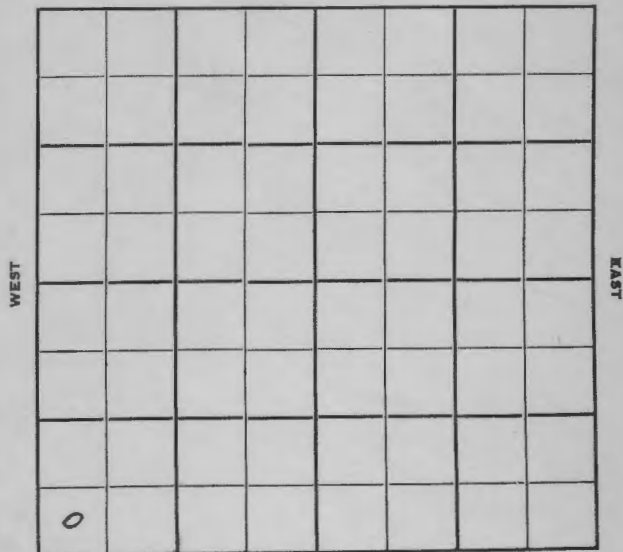

SOUTH

Sec 8 Twp 20 R 12EWell No. #1 Blair FarmLance Hill & B & R Drlg. Company

Contractor

Wildcat

Ft. from N. Line


330' Ft. from S. Line

Ft. from E. Line

330' Ft. from W. Line

SW SW SW

NORTH

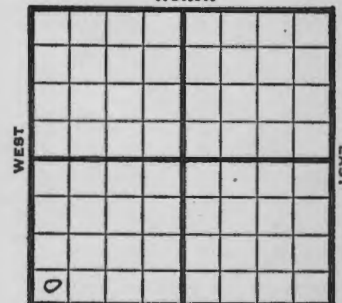

SOUTH

1950

Elev. 1130' REPORT

5/17

Location

6/7

8-5/8" @ 65'

Lans. 900'

KC 1195'

BKC 1335'

Miss 1948'

TD 1980'

D&A

ABANDONED

$$\begin{array}{r} 1335 \\ 1130 \\ \hline 205 \end{array}$$

Kansas Wildcat

Map No. _____ Sec. 8 Twp. 20 R. 12E

Well No. 1 Blair

Lance Hill & B & R Drlg. Company

Contractor

SW SW SW

SECTION PLAT



Ft. from N. Line

330 Ft. from S. Line

Ft. from E. Line

330 Ft. from W. Line

Lyon

El. Elev.

Location

Rig up

Drilling and Remarks:

RECORD

Cased in, ft.

Sand

Gas

Oil

Total Depth

PRODUCTION

1st 24 hrs. Nat.

1st 24 hrs. after shot

Gas Cu. Ft.

Dry Hole

Abandoned

Date

MAY 17 1950

19

J. E. TYRA Scout

Kansas Wildcat

Map No. _____ Sec. 8 Twp. 20 R. 12E

Well No. 1 Blair

Lance Hill & B & R Drlg. Company

Contractor

SW SW SW

El. 1130

SECTION PLAT



Ft. from N. Line

230 Ft. from S. Line

Ft. from E. Line

230 Ft. from W. Line

Lyon

Location

Rig up

Drilling and Remarks:

8 5/8" @ 65'

Lans 2900

KC 1195

BKC 1335

Miss 1948

D + A

RECORD

Cased in, ft.

Sand

Gas

Oil

Total Depth 1980

PRODUCTION

1st 24 hrs. Nat.

1st 24 hrs. after shot

Gas Cu. Ft.

Dry Hole

Abandoned

Date

JUN 7 1950

J. E. TYRA Scout