


Coffey

Map No. KANSAS Sec. 14 Twp. 20 R. 13^E

Well No. 1- Rich Farm

Rockhill et al Company

NORTH

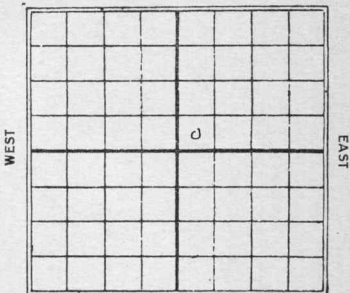

_____ Ft. from N. Line

250 Ft. from S. Line

_____ Ft. from E. Line

250 Ft. from W. Line

1930

Date

REPORT

Date	REPORT
<u>9/24</u>	<u>Loc</u>
<u>10/11</u>	<u>—</u>
<u>10/18</u>	<u>—</u>
<u>10/15</u>	<u>—</u>
<u>10/22</u>	<u>—</u>
<u>10/29</u>	<u>Ran up</u>
<u>11/5</u>	<u>Spdy 310'</u>
<u>11/12</u>	<u>dry 850'</u>
<u>11/19</u>	<u>" 1590</u>
<u>11/25</u>	<u>Top line 1685</u>
	<u>T.D. 1734</u>
	<u>Dry & Abandon</u>

Copsey

Map No. KANSAS Sec. 14 Twp. 20 R. 13^E

Well No. 1 *Rich*

Rockhill et al Company

Contractor

COMPLETE

SECTION PLAT

..... Ft. from N. Line

750 Ft. from S. Line

..... Ft. from E. Line

750 Ft. from W. Line

		0	

ABANDONED

Location.....

Rig up.....

Drilling and Remarks:

Log Line 1685
D + G 1734

RECORD

Cased..... in., ft.

Sand.....

Gas.....

Oil.....

Total Depth 1734'

PRODUCTION

1st 24 hrs. Nat.....

1st 24 hrs. after shot.....

Gas..... Cu. Ft.

Dry Hole

Abandoned

Date

NOV 25 1930

CHAS. L. SHERWOOD

192

Scout

KANSAS

Map No. 20 Sec. 14 Twp. 20 R. 13^E

Well No. 1 Rich
Hockley et al Company

Contractor

FIRST REPORTS

SECTION PLAT

_____ Ft. from N. Line

750 Ft. from S. Line

_____ Ft. from E. Line

750 Ft. from W. Line

		o	

Location ✓

Rig up _____

Drilling and Remarks:

RECORD

Cased _____ in., _____ ft.

Sand _____

Gas _____

Oil _____

Total Depth _____

PRODUCTION

1st 24 hrs. Nat. _____

1st 24 hrs. after shot _____

Gas _____ Cu. Ft.

Dry Hole _____

Abandoned _____

Date SEP 2 1930

19 CHAS. L. SHERWOOD Scout