

KANSAS Chase ✓Section 14 Township 20 Range 7EWell No. 1 StarkeyCompany Amerada**Wildcat**

NORTH

							0

WEST

EAST

SOUTH

KANSAS

Chase

Sec. 14 Twp. 20 R. 7E ✓

Well No. #1 Starkey Farm

Amerada

Company

Wildcat

 Ft. from N. Line

330'


 Ft. from S. Line

330'

 Ft. from E. Line

 Ft. from W. Line

SE/C

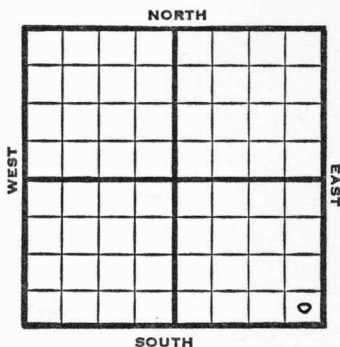

1949

R E P O R T

2/16 Location

2/23 "

3/2 "

3/9 TD 1910'
Aband.

ABANDONED

Map No. _____ Sec. 14 Twp. 20 R. 7EWell No. 1 StarkeyAmerada

Company

FIRST REPORT

Contractor


SE/C

SECTION PLAT

_____ Ft. from N. Line

330 Ft. from S. Line330 Ft. from E. Line

_____ Ft. from W. Line

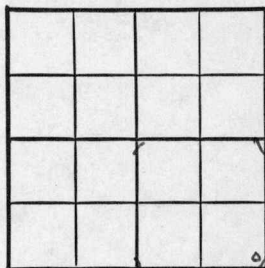Chase PoolLocation X

Rig up _____

Drilling and Remarks:

RECORD

Cased _____ in., _____ ft.

Sand _____

Gas _____

Oil _____

Total Depth _____

PRODUCTION

1st 24 hrs. Nat. _____

1st 24 hrs. after shot _____

Gas _____ Cu. Ft.

Dry Hole _____

Abandoned _____

Date

FEB 16 1949 19S. J. LEWIS

Scout

Kansas

Wildcat

Map No. K22 Sec. 14 Twp. 20 R. 7EWell No. 1 Starkey

Amerada

Company

ABANDONED

Contractor

SE/C

SECTION PLAT

			6

 Ft. from N. Line330 Ft. from S. Line330 Ft. from E. Line Ft. from W. Line

Chase County

Location Rig up

Drilling and Remarks:

RECORD

Cased in., ft.Sand Gas Oil Total Depth 1910

PRODUCTION

1st 24 hrs. Nat. 1st 24 hrs. after shot Gas Cu. Ft.Dry Hole Abandoned

Date

MAR 9 1949S. J. LEWIS Scout