


KANSAS

FORM 51 5M 10-41 PETROL

Chase

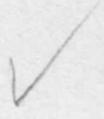


Section 15 Township 20 Range 7-E

Well No. #1 Drummond

Company Aladdin Petr. et al
~~O. J. Connell et al~~

NORTH Miscellaneous

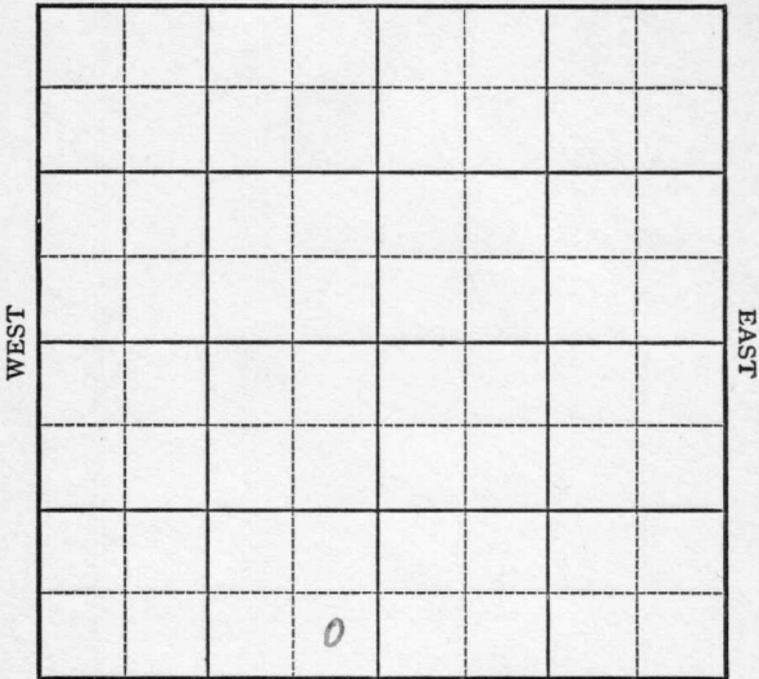

SOUTH

Chase

KANSAS

Map No. 22 Sec. 15 Twp. 20 R. 7E

Well No. 1 Drummond

O. J. Connell et al. Company

FIRST REPORT Contractor

SE SW

SECTION PLAT

_____ Ft. from N. Line

330 Ft. from S. Line

330 Ft. from E. Line

_____ Ft. from W. Line

MISCELLANEOUS

Location _____

Rig up _____

Drilling and Remarks:

Moving in Cable

Tools

RECORD

Cased _____ in., _____ ft.

Sand _____

Gas _____

Oil _____

Total Depth _____

PRODUCTION

1st 24 hrs. Nat. _____

1st 24 hrs. after shot _____

Gas _____ Cu. Ft.

Dry Hole _____

Abandoned _____

Date

DEC 3 1941 19

S. J. LEWIS Scout

Map No. 22 Sec. 15 Twp. 20 R. 7E

Well No. 1 Drumond

Aladdin Petroleum et al. Company

CORRECTION

Contractor

SE SW


SECTION PLAT

_____ Ft. from N. Line

330 Ft. from S. Line

330 Ft. from E. Line

_____ Ft. from W. Line

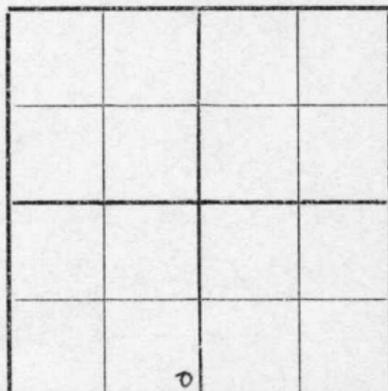

MISCELLANEOUS

Location _____

Rig up _____

Drilling and Remarks:

Reported as

O. J. Connell,
etal.

RECORD

Cased _____ in., _____ ft.

Sand _____

Gas _____

Oil _____

Total Depth _____

PRODUCTION

1st 24 hrs. Nat. _____

1st 24 hrs. after shot _____

Gas _____ Cu. Ft.

Dry Hole _____

Abandoned _____

Date

JAN 7 1942 19

S. J. LEWIS Scout

Map No. 22 Sec. 15 Twp. 20 R. 7E

Well No. 1 Drummond

Aladdin Petroleum etal Company

ABANDONED

Contractor

SE SW

SECTION PLAT

_____ Ft. from N. Line

330 Ft. from S. Line

330 Ft. from E. Line

_____ Ft. from W. Line

MISCELLANEOUS

Location _____

Rig up _____

Drilling and Remarks:

lens 1515
KC 1722
Ar 2133
Basal dol 2172
Granite 2025.
No shows

RECORD

Cased _____ in., _____ ft.

Sand _____

Gas _____

Oil _____

Total Depth 2409

PRODUCTION

1st 24 hrs. Nat. _____

1st 24 hrs. after shot _____

Gas _____ Cu. Ft.

Dry Hole _____

Abandoned _____

Date

FEB 4 1942 19

S. J. LEWIS Scout