

Form 51-5M-9-28-27423
Map No. **KANSAS** Sec. 15 Twp. 20 R. 4^E

Well No. 1-Ford Farm
Sumclair Company

NORTH

[illegible]

SOUTH

Location.....

Drilling Remarks

Rig Up.....

Drilling Remarks

RECORD

Cased.....in.....ft.

Sand.....

Gas.....

Oil_____

Total Depth.....

PRODUCTION

1st 24 hrs. Nat.....

1st 24 hrs. after shot.....

Gas.....cu. ft.....

Dry Hole.....

Abandoned.....

Map No. Sec. Twp. R.

Well No. Farm


..... Company

..... Ft. from N. Line

..... Ft. from S. Line

..... Ft. from E. Line

..... Ft. from W. Line

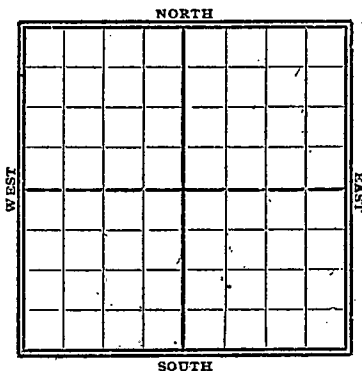

1920

Date

REPORT

Gypsy Records

2/9

Abd T D 3011'

MAP No. _____ SEC. 15 TWP. 20S. 4EWELL No. 1 2000Senclair COMPANY_____
CONTRACTOR

SECTION PLAT

		0	

Ft. FROM N. LINE_____
Ft. FROM S. LINE_____
Ft. FROM E. LINE_____
Ft. FROM W. LINE

LOCATION _____

RIG UP _____

DRILLING AND REMARKS:

*we show
3001
not
changing*

RECORD

Cased _____ IN. _____ FT.

SAND _____

GAS _____

OIL _____

TOTAL DEPTH 3011

PRODUCTION

1ST 24 HRS. NAT. _____

1ST 24 HRS. AFTER SHOT _____

GAS _____ CU. FT.

DRY HOLE ☒ABANDONED ☒

DATE

7/9 1920 _____ SCOUT