

KANSAS

Lyon



Section 16 Township 20S Range 11E

Well No. "1 Watts

Company A. R. Jones et al

NORTH

WEST

EAST

					0		

SOUTH

Lyon ✓

Sec. 16 Twp. 20 R. 11-E

Well No. #1 Watts Farm _____

A R Jones etal

Company _____

Cont— Pabco Drlg

Wildcat

330

Ft. from N. Line


_____ Ft. from S. Line

_____ Ft. from E. Line

990

Ft. from W. Line

NORTH

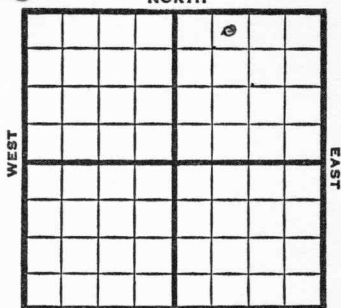

SOUTH

NE NW NE

1949

Elev 1208'

R E P O R T

10/12

8" @ 136

Drlg 1330'

10/19

TD 2665'

Lansing 1030'

KC 1329'

Miss 2047'

Viola 2509'

Simp Sd 2596'

Arb. 2644'

Aband.

ABANDONED

Map No. _____ Sec. 16 Twp. 20 R. 11E

Well No. 1 Watts

A. R. Jones et al. Company

Pabco Drlg. Contractor

NE NW NE


FIRST REPORT
SECTION PLAT

330 Ft. from N. Line

_____ Ft. from S. Line

_____ Ft. from E. Line

990 Ft. from W. Line

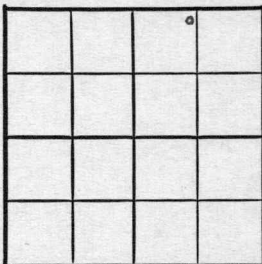

Lyon County

Location _____

Rig up _____

Drilling and Remarks:

8" @ 136

drlg. 1330

RECORD

Cased _____ in., _____ ft.

Sand _____

Gas _____

Oil _____

Total Depth _____

PRODUCTION

1st 24 hrs. Nat. _____

1st 24 hrs. after shot _____

Gas _____ Cu. Ft.

Dry Hole _____

Abandoned _____

Date

OCT 12 1949

19

S. J. LEWIS

Scout

Kansas

Map No. _____ Sec. 16 Twp. 20 R. 11EWell No. 1 Watts

A. R. Jones et al. _____ Company

ABANDONED

Contractor

NE NW NE

E11/208
SECTION PLAT

		0	

330 Ft. from N. Line

_____ Ft. from S. Line

_____ Ft. from E. Line

990 Ft. from W. Line

Lyon County

Location _____

Rig up _____

Drilling and Remarks:


RECORD

Cased _____ in., _____ ft.

Sand _____

Gas _____

Oil _____

Total Depth 2665

PRODUCTION

1st 24 hrs. Nat. _____

1st 24 hrs. after shot _____

Gas _____ Cu. Ft.

Dry Hole _____

Abandoned _____

Date

OCT 19 1949

19

S. J. LEWIS

Scout