


Map No. _____ Sec. 16 Twp. 20 R. 11
Well No. 1 Cowan Farm _____
Empire O. & F. Company _____

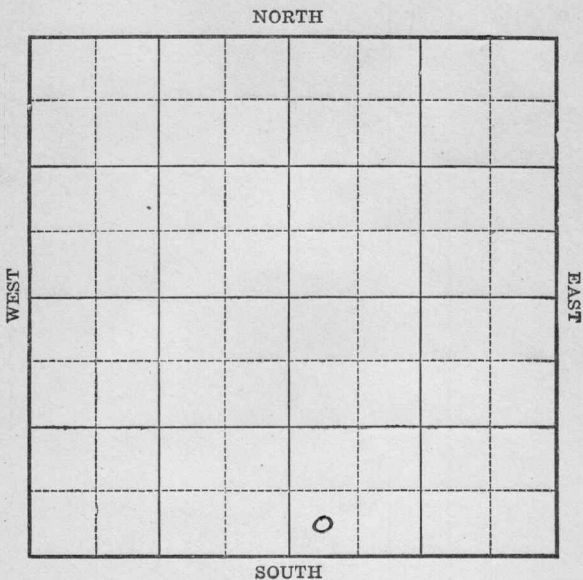

Location _____

Drilling Remarks:

RECORD

Cased _____ in. _____ ft.

Sand _____

Gas _____

Oil _____

Total Depth _____

Rig up _____

Drilling Remarks:

PRODUCTION

1st 24 hrs Nat. _____

1st 24 hrs. after shot _____

Gas _____ cu. ft.

Dry Hole _____

Abandoned _____

21 KANSAS 16 20 11
 Map No. _____ Sec. _____ Twp. _____ R. _____

Well No. Cavan
Empire 6x7 Company

Contractor _____

ABANDONED

SECTION PLAT

		0	

_____ Ft. from N. Line

330 _____ Ft. from S. Line

_____ Ft. from E. Line

330 _____ Ft. from W. Line

Location _____

Rig up _____

Drilling and Remarks:

10x9
 2946

RECORD

Cased _____ in., _____ ft.

Sand _____

Gas _____

Oil _____

Total Depth _____

PRODUCTION

1st 24 hrs. Nat. _____

1st 24 hrs. after shot _____

Gas _____ Cu. Ft.

Dry Hole _____

Abandoned _____

Date

AUG 15 1923

M. A. BENEAR

Scout

Lyon Co.

Map No. *21 Kans* Sec. *16* Twp. *20* R. *11*

Well No. *1 Cowan*

Empire B & F Company

Contractor

First Report

SECTION PLAT

Ft. from N. Line

330 Ft. from S. Line

Ft. from E. Line

330 Ft. from W. Line

Location

Rig up

Drilling and Remarks:

Log 2740'

RECORD

Cased in., ft.

Sand

Gas

Oil

Total Depth

PRODUCTION

1st 24 hrs. Nat.

1st 24 hrs. after shot

Gas Cu. Ft.

Dry Hole

Abandoned

Date

8/4 192*3*

M.B. Scout