

Well No. 1 Reese Farm

M. B. Leonard Company

~~Mc-777777~~ NORTH

J. V. McMahon & J. M. B. Leonard

WEST

EAST

SOUTH

Drilling Remarks

Drilling Remarks

RECORD

Sand

Gas

Oil

Total Depth _____

PRODUCTION

1st 24 hrs. Nat. _____

1st 24 hrs. after shot -----

Gas_____cu. ft.

Dry Hole

Abandoned

Lyon Co
 Map No. *Kansas* Sec. *16* Twp. *20* R. *10*
 Well No. *1* *Reece* Farm
~~*M. B. Leonard*~~ Company
Mc Mann oil & M. B. Leonard

Ft. from N. Line

200 Ft. from S. Line


Ft. from E. Line

200 Ft. from W. Line

WEST

EAST

SOUTH

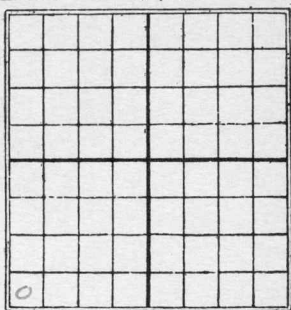

Date 1925 REPORT

11/6 Location

11/12

11/19

11-27

12/3 Timbers.

12/10 Bldg rig.

12/17

12/17 Rigging up.

12/23

12/31

1926

1/8 Spudded

1/4 Drlg 400'

2/0 Drlg 1500'

2/7 S. D. 1500'

3/4 U. R. 10" 1600'

3/10 Dlg 1685'

2/17 Drlg 2000'

2/24

Cleaning out

2000' Chg ownership

3/5 Top line 2451 T.D.:-

2455 running 5"

Lyon County

K21 Map No. **KANSAS** Sec. *16* Twp. *20* R. *10*

Well No. *1 Bruce*

J. V. Mc Mahon & Leonard Company

Contractor

COMPLETED

SECTION PLAT

_____ Ft. from N. Line

200 Ft. from S. Line

_____ Ft. from E. Line

200 Ft. from W. Line

ABANDONED

<i>0</i>			

Location _____

Rig up _____

Drilling and Remarks:

Top line 2424'

*Drill + abandon 20
2527*

RECORD

Cased _____ in., _____ ft.

Sand _____

Gas _____

Oil _____

Total Depth *2527*

PRODUCTION

1st 24 hrs. Nat. _____

1st 24 hrs. after shot _____

Gas _____ Cu. Ft.

Dry Hole ☒

Abandoned ☒

Date

MAR 11 1926

CHAS. L. SHERWOOD

192

Scout

K21 KANSAS 16 Sec. 20 Twp. 10 R. 10

Well No. 1 Piece
M. B. Leonard Company

Contractor

FIRST REPORTS

SECTION PLAT

Ft. from N. Line

200 Ft. from S. Line

Ft. from E. Line

200 Ft. from W. Line

o			

Location ✓

Rig up

Drilling and Remarks:

RECORD

Cased _____ in., _____ ft.

Sand _____

Gas _____

Oil _____

Total Depth _____

PRODUCTION

1st 24 hrs. Nat. _____

1st 24 hrs. after shot _____

Gas _____ Cu. Ft.

Dry Hole _____

Abandoned _____

Date

NOV 6 1925

CHAS. L. SHERWOOD

192

Scout

Map No. 21 **KANSAS** Sec. 16 Twp. 20 R. 10

Well No. 1 See log
Mc Mann oil Co Company

Contractor

SECTION PLAT

Ft. from N. Line

200 Ft. from S. Line

Ft. from E. Line

200 Ft. from W. Line

CORRECTION

Location

Rig up

Drilling and Remarks:

*Digging up
 old ownership
 to above.*

RECORD

Cased _____ in., _____ ft.

Sand _____

Gas _____

Oil _____

Total Depth _____

PRODUCTION

1st 24 hrs. Nat. _____

1st 24 hrs. after shot _____

Gas _____ Cu. Ft.

Dry Hole _____

Abandoned _____

Date

DEC 17 1925

CHAS. L. SHERWOOD

192

Scout

1621 KANSAS 16 20 10
 Map No. Sec. Twp. R.

Well No. 1 Beece
 J. J. McMahon & H. B. Leonard Company

Contractor

SECTION PLAT

Ft. from N. Line

200 Ft. from S. Line

Ft. from E. Line

200 Ft. from W. Line

CORRECTION

Location

Rig up

Drilling and Remarks:

Chasing out 2000
 Chg own ship to
 chove.

RECORD

Cased in, ft.

Sand

Gas

Oil

Total Depth

PRODUCTION

1st 24 hrs. Nat.

1st 24 hrs. after shot

Gas Cu. Ft.

Dry Hole

Abandoned

Date

FEB 24 1926

CHAS. L. SHERWOOD

192

Scout