
Marion

FORM 51 10M 12-46 PETROL

Section 17 Township 20 Range 2E

Well No. 1 Pesiner

Company lion Oil Et Al

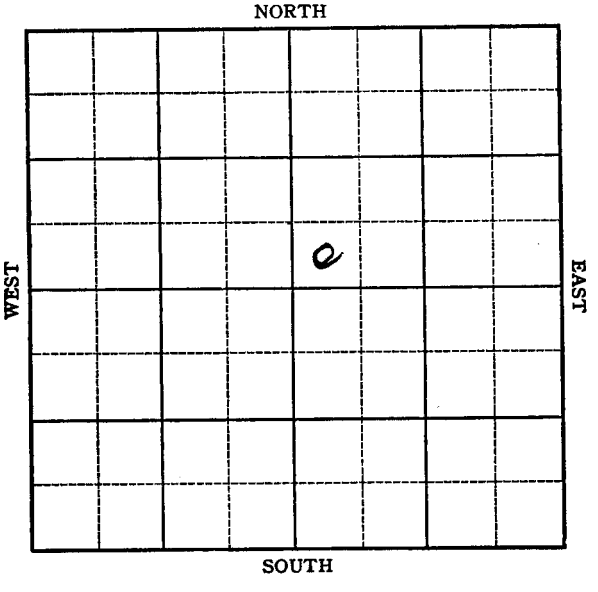

FORM 252-A
5M 12-46 PETROL KANSAS Marion V

Sec. 17 Twp. 20 R. 2-E

Well No. #1 Pesiner Farm

Lion Oil etal Company

Wildcat


____ Ft. from N. Line

330 Ft. from S. Line

____ Ft. from E. Line

330 Ft. from W. Line

SW NE

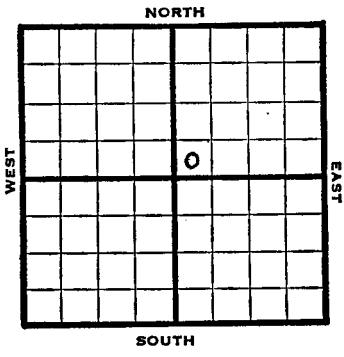

	REPORT
1947	Elev. 1382'
6/11	8" @ 100 WOC
6/17	Lansing 2046' Mississippi 2628' **Drlg. 2660'**
6/25	**TD 3200'** Lansing 2043' Mississippi 2625' Viola 3000' Simpson Sd 3086' Arbuckle 3148 **Abandoned**

ABANDONED

2043
1382
661

2625
1382
1243
661
583

Form 26 200 Bks. 10-46 Petrol

Kansas

Wildcat

Map No. _____ Sec. 17 Twp. 20 R. 2E


Well No. 1 Pesiner

Lion Oil etal. Company

FIRST REPORT Contractor

SW NE

SECTION PLAT

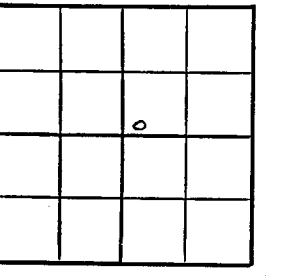

_____ Ft. from N. Line

330 Ft. from S. Line

_____ Ft. from E. Line

330 Ft. from W. Line

Marion County

Location _____

Rig up _____

Drilling and Remarks:

8" @ 100 CWOC

RECORD

Cased _____ in., _____ ft.

Sand _____

Gas _____

Oil _____

Total Depth _____

PRODUCTION

1st 24 hrs. Nat. _____

1st 24 hrs. after shot _____

Gas _____ Cu. Ft.

Dry Hole _____

Abandoned _____

Date

JUN 11 1947 19 S. J. LEWIS Scout

Form 26 200 Bks. 10-46 Petrol

Wildcat

Kansas

Map No. 24 Sec. 17 Twp. 20 R. 2E

Well No. 1 Penner


Lion Oil etal. Company

ABANDONED Contractor

SW NE

E 1/2 SE

SECTION PLAT

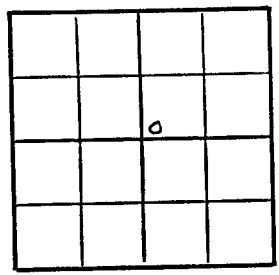

____ Ft. from N. Line

330 Ft. from S. Line

____ Ft. from E. Line

330 Ft. from W. Line

Marion County

Location

Rig up

Drilling and Remarks:

Lans 2043
Miss 2625
Viola 8000
Simp Sd 3086
LTD 3145

RECORD

Cased ____ in., ____ ft.

Sand

Gas

Oil

Total Depth 3200

PRODUCTION

1st 24 hrs. Nat.

1st 24 hrs. after shot

Gas ____ Cu. Ft.

Dry Hole

Abandoned

Date

JUN 25 1947 19 S. J. LEWIS Scout