


Section 18 Township 20 Range 10E

Well No. 1 Baker

Company Ben Brack

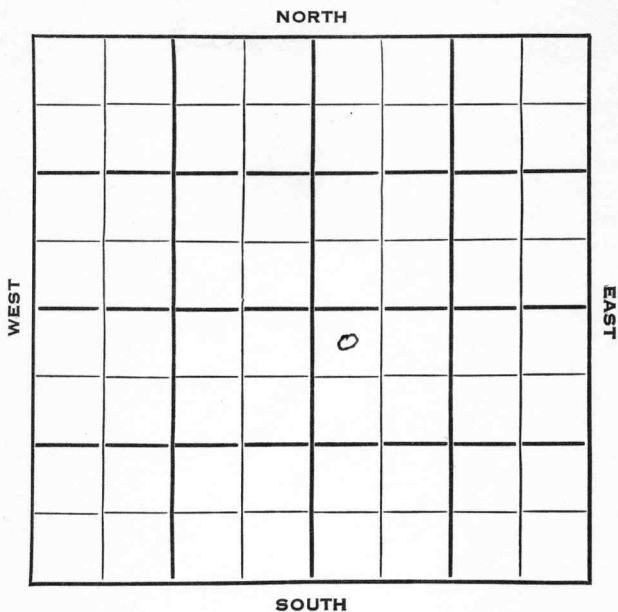

Lyon
20

KANSAS ✓

10E

Sec. 18 Twp. R.

#1 Baker

Well No. Farm

Ben Brack

Company

Contractor

Wildcat


330 Ft. from N. Line

Ft. from S. Line

Ft. from E. Line

330 Ft. from W. Line

NW NW SE

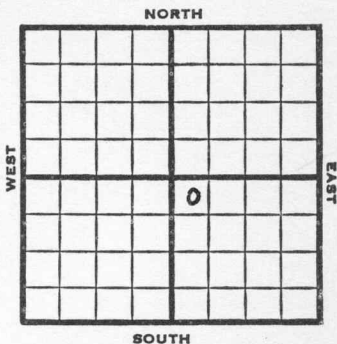

1952

Elev. - REPORT

12/23 RUR

1953
1/7

Spud 12-22-52

D&A

TD 2900

8" @71

B KC 1736, Bart 2230, Miss 2355, Kh. 2725, Viola 2793

DST 2794-2806, opn 1/2 hr., rec. 2100' wtr., 978#

Simp 2871

TD 2900

D&A

ABANDONED

2793
2355
438

