


Form 51-5M-3-26-22544

Map No. *KANS* Sec. *19* Twp. *20* R. *13*

Well No. *1* *Webb* Farm
Gasche et al Company

NORTH

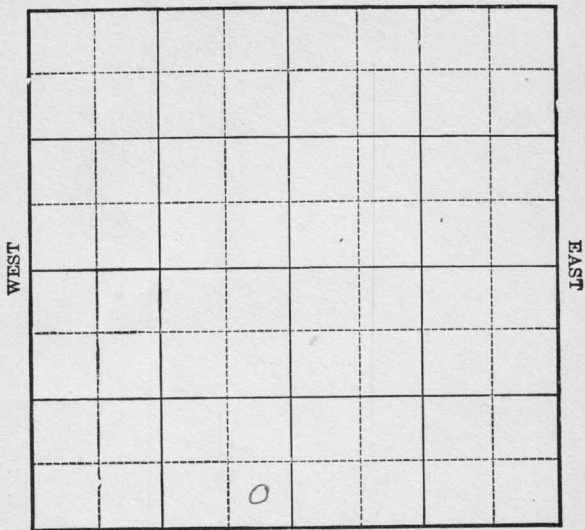

SOUTH

Location _____
Drilling Remarks _____

Rig Up _____
Drilling Remarks _____

RECORD

Cased _____ in. _____ ft.

Sand _____

Gas _____

Oil _____

Total Depth _____

PRODUCTION

1st 24 hrs. Nat. _____

1st 24 hrs. after shot _____

Gas _____ cu. ft.

Dry Hole _____


Abandoned _____

Lyzene

Map No. *Kansas* Sec. *19* Twp. *20* R. *13*

Well No. *1* *Welch* Farm
Gasche et al Company

_____ Ft. from N. Line
250 Ft. from S. Line
350 Ft. from E. Line
_____ Ft. from W. Line

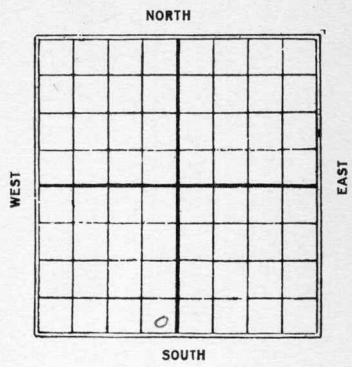

Date	REPORT
<i>1926</i>	
<i>6/17</i>	<i>Location</i>
<i>6/25</i>	
<i>6-30</i>	<i>—</i>
<i>7/8</i>	<i>—</i>
<i>7/15</i>	<i>—</i>
<i>7/22</i>	<i>—</i>
<i>7/28</i>	<i>—</i>
<i>8/4</i>	<i>—</i>
<i>8/11</i>	<i>—</i>
<i>8/18</i>	<i>—</i>
<i>8/25</i>	<i>—</i>
<i>8-31</i>	<i>—</i>
<i>9/15</i>	<i>—</i>
<i>9/22</i>	<i>—</i>
<i>9/29</i>	<i>same</i>
<i>10/3</i>	<i>—</i>
<i>10/27</i>	<i>same</i>
<i>11/11</i>	<i>Only 160'</i>
<i>11/17</i>	<i>" 435</i>
<i>11/23</i>	<i>" 435</i>
<i>12/8</i>	<i>" 1110</i>
<i>12/15</i>	<i>" 1450'</i>

12/22 - fishing 1450
12/30 - Sand 1810-1830 H.F. W
Drlg at 1835

1927

1/6 - sand 1810-30 - H.F. W
Top line 1883'
D. & A. 1902'

KANSAS

Map No. _____ Sec. 19 Twp. 20 R. 13Well No. 1 Welch
Busch et al Company

Contractor

FIRST REPORTS

SECTION PLAT

Ft. from N. Line

250

Ft. from S. Line

250

Ft. from E. Line

Ft. from W. Line

Location ✓

Rig up _____

Drilling and Remarks:

RECORD

Cased _____ in., _____ ft.

Sand _____

Gas _____

Oil _____

Total Depth _____

PRODUCTION

1st 24 hrs. Nat. _____

1st 24 hrs. after shot _____

Gas _____ Cu. Ft.

Dry Hole _____

Abandoned _____

Date

JUN 17 1926

CHAS. L. SHERWOOD

192

Scout

KANSAS

Map No. _____ Sec. _____ Twp. _____ R. _____

Well No. _____

Company _____

Contractor _____

FIRST REPORTS

_____ Ft. from N. line

_____ Ft. from S. line

_____ Ft. from E. line

_____ Ft. from W. line

SECTION PLAT

RECORD

Location _____

Log up _____

Drilling and Remarks _____

Returned _____

Cards _____

Tracing _____

France Map _____

Scarborough Map _____

Moody Map _____

Scarborough Plat Book _____

Moody Plat Book _____

Date _____

KANSAS

Map No. _____ Sec. 19 Twp. 20 R. 13

Well No. 1 Welch

Busche et al Company

Contractor

COMPLETED

SECTION PLAT

Ft. from N. Line

250 Ft. from S. Line

250 Ft. from E. Line

Ft. from W. Line

ABANDONED

Location _____

Rig up _____

Drilling and Remarks:

Sand 1810-30 AFU

Tap line 1883'

OK

1902

RECORD

Cased _____ in., _____ ft.

Sand _____

Gas _____

Oil _____

Total Depth 1902

PRODUCTION

1st 24 hrs. Nat. _____

1st 24 hrs. after shot _____

Gas _____ Cu. Ft.

Dry Hole ✓

Abandoned ✓

Date

JAN 6 1907

CHAS. L. SHERWOOD

192

Scout

KANSAS

Map No. _____
Sec. _____ Twp. _____ R. _____

Well No. _____

Company _____

Contractor _____

SECTION PLAT

WATERFLOOD

ft. from N. line _____

ft. from S. line _____

ft. from E. line _____

ft. from W. line _____

Remarks _____

RECORD

Classed _____
Sand _____
Gas _____
Oil _____

Location _____
Hole up _____
Drilling and Remarks _____

Returned	_____
Cards	<i>m</i>
Tracing	<i>None</i>
France Map	_____
Scarborough Map	_____
Moody Map	_____
Scarborough Plat Book	_____
Moody Plat Book	_____

Date _____