


Marion

KANSAS

SECTION 2 TOWNSHIP 20 RANGE 3E

WELL NO. #1 Ehrlich

COMPANY Stelbar

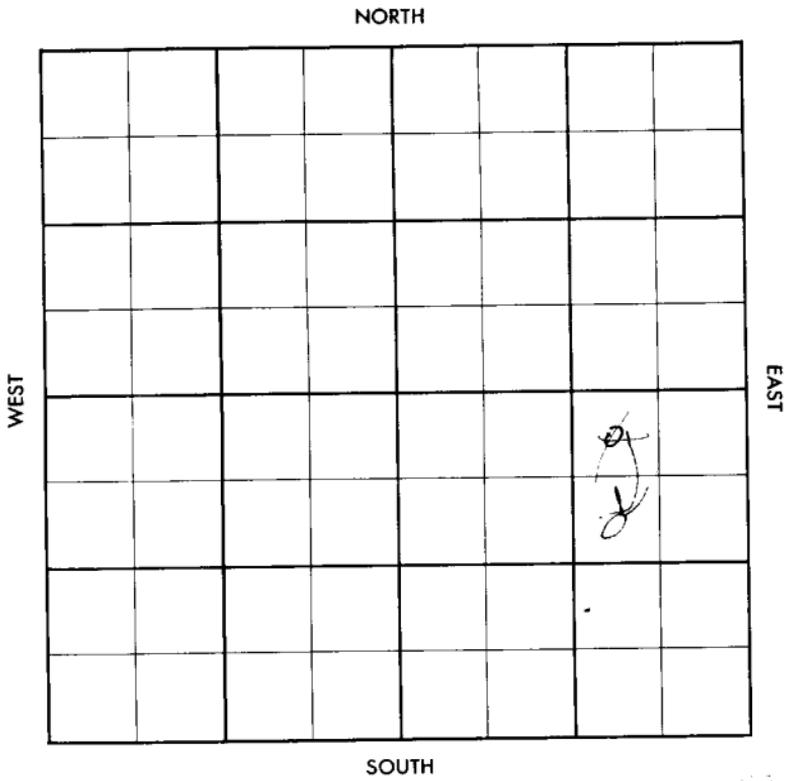

Marion

KANSAS

SEC. 2	TWP. 20	R. 3E
-----------	------------	----------

WELL NO. #1 Ehrlich FARM

COMPANY Stelbar

CONTRACTOR Smitherman


ILLUSTRATION

_____ Ft. from N. Line

_____ Ft. from S. Line

_____ Ft. from E. Line

_____ Ft. from W. Line

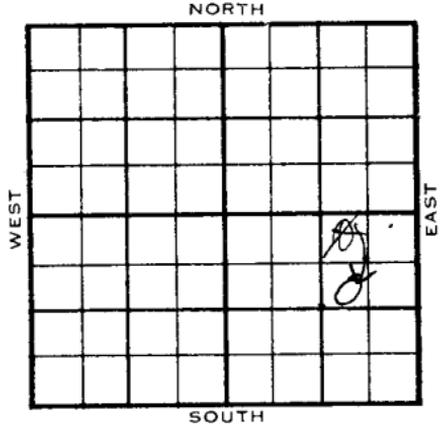

SW
NW NE ~~###~~ SE

1956	ELEVATION 1360'	REPORT
------	--------------------	--------

4-25 Comm. 4-22-56
8" @ 95 w/100
Drlg. 270

5-9 DST 2357-76 op 1 hr. rec. 30' mud,
BHP 140#.
D & A
L. 1809', Ce. 2263', M. 2354', K. 2432
Dolo. 2615', Chert. 2632', V.Dolo. 2647
TD 2668'

ABANDONED

2354
1360
994

County Marion Elev. _____
 Sec. 2 Twp. 20 Rge. 3E
 Company Sulbar
 Farm Name Ehrlich No. 1

TOPS	DEPTH	LOG	DATUM
Anh.			
Tp.			
H.			
Tr.			
Dg.			
Bl.			
L.			
N.C.			
B.K.C.			
Ce.			
C.			
M.			
M.			
K.			
Mz.			
Mo.			
V.			
S.			
S.			
A.			
R.			
Pe.			
G.			
TD			

Loc. in Sec. NW NE SE
 Geol. _____
 Contr. Smitherman
 Pool Wildcat
 FIRST REPORT
 APR 25 '56

Date Comm. 4-22-56
8" @ 95/100 d.c.g. 270

1951 STEAM

[Handwritten signature]

CORRECTION

FORM 513 SUNRAY

County Marion Elev. 1360
 Sec. 2 Twp. 20 Rge. 3E
 Company Stellar
 Farm Name Ehrlich No. 1

TOPS	DEPTH	LOG	DATUM	Loc. in Sec.
Ank.				NW NE SE SW
Tr.				
H.				
Tr.				
Dg.				
Bl.				
L.	1809			Geol.
K.C.				
B.K.C.				Contr.
Ce.	2263			Smitherman
C.				
M.	2354			Pool
M.				Wildcat
K.	2432			
Mz.				
Mo. <u>Dolo</u>	2615			<div style="border: 1px dashed black; padding: 5px; display: inline-block;"> ABANDONED X A e </div>
V. <u>cheet</u>	2632			
S. <u>V. Dolo</u>	2647			
S.				
A.				
R.				
PC.				
G.				
TD.	2668			

Date Comm. 4-22-56 MAY 9 1956
8" @ 95/100 drlg. 270 MAY 2 '56 MAY 9 '56
DST 2357-76 1 hr sec 30' Md
BHP 140

D & A ~~(initials)~~