

Map No. KANSAS Sec. 20 Twp 20 R. 10^E

Well No. 1- Higbee Farm

Speedy et al Company


330 Ft. from N. Line

_____ Ft. from S. Line

990 Ft. from E. Line

_____ Ft. from W. Line

1932

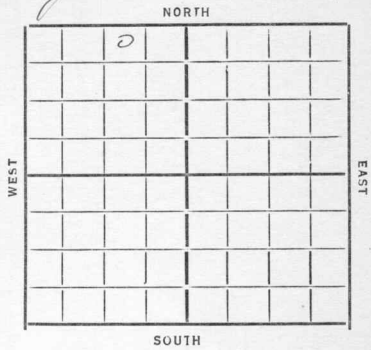

Date	REPORT
11/23	Rgd up + SID
11/30	—
12/7	Rgn up
12/14	—
12/21	SID 700'
12/28	—
1933	—
1/4	—
1/11	—
1/18	6" 2190 drg
1/25	SID 2190'
2/1	—
2/8	No sand
	Top line 2395
	Water at 2440
	TD 2445
	Dry & Abandon

21 KANSAS Sec. 20 Twp. 20 R. 10 E

Well No. 1 Higbee

Sheedy & Co Company

Contractor

FIRST REPORTS

330 Ft. from N. Line

Ft. from S. Line

990 Ft. from E. Line

Ft. from W. Line

SECTION PLAT

	o		

Location

Rig up

Drilling and Remarks:

Rigged up
A/D

RECORD

Cased in., ft.

Sand

Gas

Oil

Total Depth

PRODUCTION

1st 24 hrs. Nat.

1st 24 hrs. after shot

Gas Cu. Ft.

Dry Hole

Abandoned

Date

NOV 23 1932 CHAS. L. SHERWOOD

192 Scout

Lynn

F

21 **KANSAS** Map No. Sec. *20* Twp. *20* R. *10*

Well No. *31 Higher*

Shedy & Co Company

Contractor

COMPLETED

SECTION PLAT

330 Ft. from N. Line

..... Ft. from S. Line

990 Ft. from E. Line

..... Ft. from W. Line

	0		

ABANDONED

Location.....

Rig up.....

Drilling and Remarks:

No Sand

Top Line 2395

Water 2440

RECORD

Cased..... in., ft.

Sand.....

Gas.....

Oil.....

Total Depth *2445*

PRODUCTION

1st 24 hrs. Nat.....

1st 24 hrs. after shot.....

Gas..... Cu. Ft.

Dry Hole

Abandoned

Date

FEB 8 1933

CHAS. L. SHERWOOD

192..... Scout