

Section 20 Township 20 Range 10 EWell No. # 1 WendlingCompany C. L. Sheedy

|       |  |  |  |  |  |  |  |
|-------|--|--|--|--|--|--|--|
| NORTH |  |  |  |  |  |  |  |
| WEST  |  |  |  |  |  |  |  |
|       |  |  |  |  |  |  |  |
|       |  |  |  |  |  |  |  |
| SOUTH |  |  |  |  |  |  |  |
| EAST  |  |  |  |  |  |  |  |

# Lyon KANSAS

|                |                |                |
|----------------|----------------|----------------|
| SEC.<br><br>20 | TWP.<br><br>20 | R.<br><br>10 E |
|----------------|----------------|----------------|



WELL NO. # 1 Wendling

COMPANY FARM

CONTRACTOR C. L. Sheedy

Ola Berentz


Welch-Mohr Pool

Ft. from N. Line

330 Ft. from S. Line

Ft. from E. Line

990 Ft. from W. Line

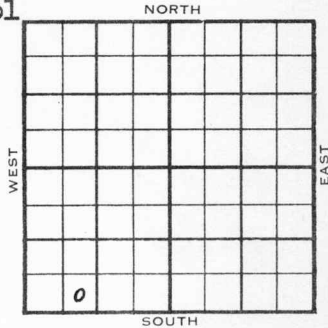

SE SW SW

D & E Drlg. - DHM

| 1954 | ELEVATION | REPORT |
|------|-----------|--------|
|      | 1422' RB  |        |

7/7 Spud 6-28-54


D & A TD 2370' 10" @ 60

Cattleman sd 2287-99'

TD 2370' D & A

**FIRST REPORT  
ABANDONED**

County **Lyon** State **Kansas**  
 Sec. **20** (Blk. **20** (Sur. **10E** Map No.  
 (Twp.) (Rge.)  
 Operator **C. L. Sheedy**  
 Well No. **1** Farm **Wendling**  
 Elev. **1422 RB** Location **SE SW SW**

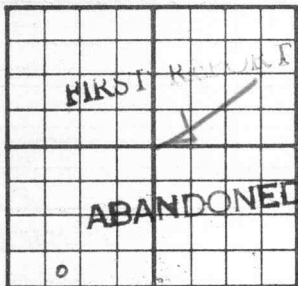

**330** Ft. From **S** Line **SW**  
**990** Ft. From **W** Line Quarter  
 Ist. Report **JUL 7 1954**  
 Completion **JUL 7 1954**  
 Remarks **D & E Drlg. - DHM**  
**Ola Berentz - Contr.**  
 Spudding Date **6-28-54**

Drlg. Data **D & A TD 2370 Welch-Mohr Pool**  
**10" @ 60 Cattleman sd. 2287-99**  
**TD 2370**

**D & A**