KANSAS


FORM 51 5M 6-46 PETROL

Marion County

Section 22 Township 20 Range 4E

Well No. #1 Meisinger

Company S. & S. Oil et al

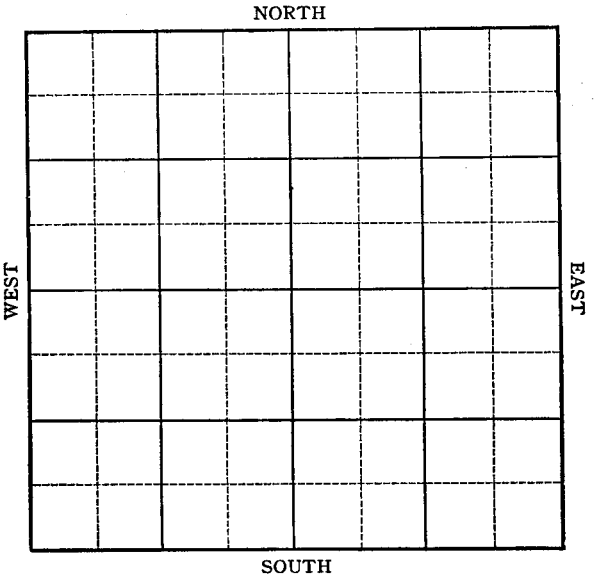

FORM 252-A
5M 6-46 PETROL

KANSAS

Marion County ✓

Sec. 22 Twp. 20 R. 4E

Well No. #1 Meisinger Farm

S. &. S. Oil et al Company

Wildcat


330 Ft. from N. Line

_____ Ft. from S. Line

_____ Ft. from E. Line

330 Ft. from W. Line

NW SW

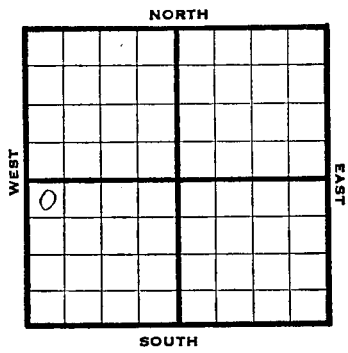

1946	REPORT
7/24	Rig
7/30	"
8/6	53' run 20"
8/13	20" @ 54', 230 Run 15"
8/20	15" @ 220 Drlg 760'
8/27	12" @ 983 Drlg 1405'
9/5	Topeka 1105 Lans 1609, 10" @ 1609 Drlg 2085'
9/10	Miss 2203' 6" @ 2240 Drlg 2437'
9/18	Viola 2440' S [illegible] 2564' TD 2620'

ABANDONED

FORM 56 200 BKS. 1-44 PETROL

KANSAS

Kansas Pool Name Wildcat

Map No. 23 Sec. 22 Twp. 20 R. 4E

Well No. 1 Meisinger

S. &. S. Oil etal Company

FIRST REPORT Contractor

NW SW


330 Ft. from N. Line

Ft. from S. Line

Ft. from E. Line

330 Ft. from W. Line

SECTION PLAT

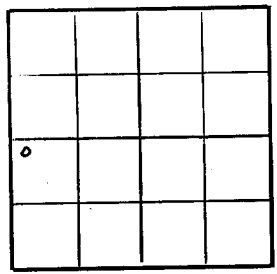

Marion County

Location

Rig up

Drilling and Remarks:

Rig.

RECORD

Cased in., ft.

Sand

Gas

Oil

Total Depth

PRODUCTION

1st 24 hrs. Nat.

1st 24 hrs. after shot

Gas Cu. Ft.

Dry Hole

Abandoned

Date

JUL 24 1946 19

S. J. LEWIS Scout

FORM 56 200 BKS. 1-44 PETROL

KANSAS 2 3 Kansas Pool Name Wildcat

Map No. 2 3 Sec. 22 Twp. 20 R. 4E

Well No. 1 Meisinger


S & S Oil Etal. Company

ABANDONED Contractor

NW SW

E 1,315

SECTION PLAT

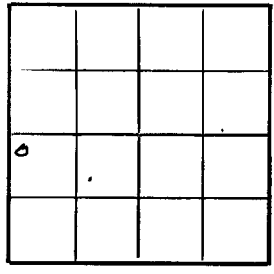

330 Ft. from N. Line

Ft. from S. Line

Ft. from E. Line

330 Ft. from W. Line

Marion County

Location

Rig up

Drilling and Remarks:

Vista 2450

Simp 2564

RECORD

Cased in., ft.

Sand

Gas

Oil

Total Depth 2620

PRODUCTION

1st 24 hrs. Nat.

1st 24 hrs. after shot

Gas Cu. Ft.

Dry Hole

Abandoned

Date

SEP 1 8 1946 19

S. J. LEWIS Scout