
Form 51—5M—7-25—19786

4 26 V

Map No. KANSAS Sec. 25 Twp. 20 R. 12

Well No. 1 — 5 Stratton Farm

Gasche & Bellire Company

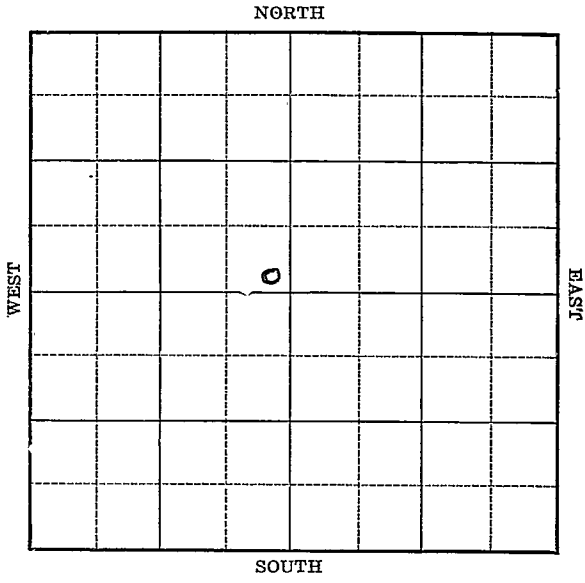

Location

Drilling Remarks

Rig Up

Drilling Remarks

RECORD

Cased in. ft.

Sand

Gas

Oil

Total Depth

PRODUCTION

1st 24 hrs. Nat.

1st 24 hrs. after shot

Gas cu. ft.

Dry Hole

Abandoned

Form 252A—5M—7-25—12664

Map No. Kansas Sec. 25 Twp. 20 R 12

Well No. 1 Stratton Farm


Gasche & Belliere Company

____ Ft. from N. Line

250 Ft. from S. Line

250 Ft. from E. Line

____ Ft. from W. Line

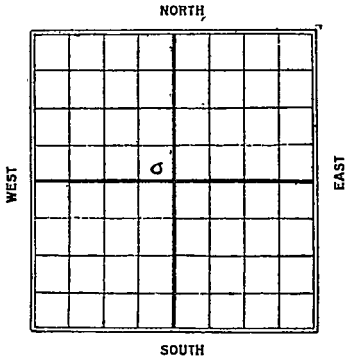

Date	REPORT
1926	
12/31	Location
1926	
1/8	—
1/14	—
1/20	—
1/27	—
2/4	—
2/10	—
2/17	—
2/24	—
3/5	—
3/10	—
3/18	—
3/25	—
4/1	—
4/9	—
4/15	—
4/21	—
4/28	—
5/8	Same.
5/14	—
5/19	—

6/2 — same
6/10 — ——
6/18 — ——
6/25 — spudding
6-30 Fdg 460'
7/8 — ——
7/15 — Drlg 800
7/22 ——
7/28 — " 1180
8/4 " 1300
8/11 — U.R. 8" 1430
8/18 — Csg. Csg. T.D. 1430
8/25 — same
8-31 D/R 8" 1570'
9/15 — S.D. 1675
9/22 — running 5" 1700'
9/29 — U.R. 5" 1800'
10/13 — Drlg 1850'

10/18 — Letter T.D. 1977
Barbarville sand 1761-76
Top miss lime 1928 being
Plugged @ 1977
measured by Sherwood

10/20 — Sand 1761-1776
top lime 1928
R. & A. 1977'

Form 26—1M Bks.—3-23—11959. Lupton Co


21
Map No. KANSAS Sec. 25 Twp. 20 R. 12

Well No. 1 Stratton

Basche & Bellows Company

Contractor

SECTION PLAT

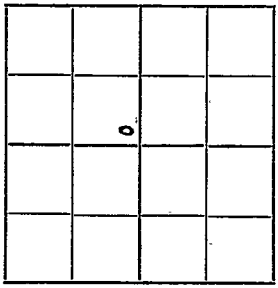

Ft. from N. Line

250 Ft. from S. Line

250 Ft. from E. Line

Ft. from W. Line

FIRST REPORTS

Location ✓

Rig up

Drilling and Remarks:

RECORD

Cased in., ft.

Sand

Gas

Oil

Total Depth

PRODUCTION

1st 24 hrs. Nat.

1st 24 hrs. after shot

Gas Cu. Ft.

Dry Hole

Abandoned

Date

DEC 3 1 1925 192

CHAS. L. SHERWOOD Scout

Returned	
Cards	M L
Tracing	MBL
France Map	Macgall map
Scarborough Map	
Moody Map	
Scarborough Plat Book	
Moody Plat Book	

Form 26—1M Bks.—3-23—11959.

Lyon

21 KANSAS

Map No. _____ Sec. 25 Twp. 20 R. 12

Well No. 1 Stratton

Bach & Bellows Company

_____ Contractor

COMPLETED

_____ Ft. from N. Line


250 Ft. from S. Line

250 Ft. from E. Line

_____ Ft. from W. Line

Delayed Contract

SECTION PLAT

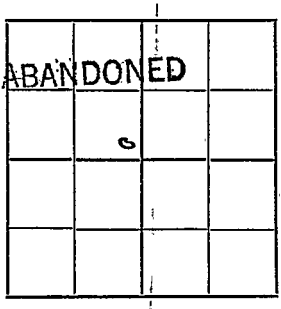

Location _____

Rig up _____

Drilling and Remarks:

Top Lime 1922

Abd 1977

RECORD

Cased 1 in., 1 ft.

Sand 1761-1776

Gas _____

Oil _____

Total Depth 1977

PRODUCTION

1st 24 hrs. Nat. _____

1st 24 hrs. after shot _____

Gas _____ Cu. Ft.

Dry Hole _____

Abandoned _____

Date

OCT 20 1926 192

CHAS. L. SHERWOOD Scout