


Map No. _____ Sec. 27 Twp. 20 R. 11
Well No. 4 Maurice Farm _____
Orlando Ref Company _____

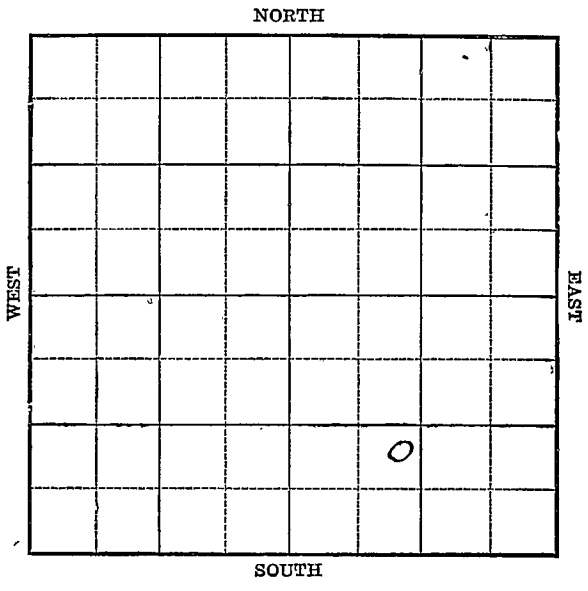

Location _____

Rig up _____

Drilling Remarks:

Drilling Remarks:

RECORD

PRODUCTION

Cased _____ in. _____ ft.

1st 24 hrs Nat. _____

Sand _____

1st 24 hrs. after shot _____

Gas _____

Gas _____ cu. ft.

Oil _____

Dry Hole _____

Total Depth _____

Abandoned _____

Map No. **KANSAS** Sec. **27** Twp. **20** R. **11**

Well No. **1** *Maurine*
Orlando Pet Company

Contractor

ABANDONED FIRST REPORT

SECTION PLAT

_____ Ft. from N. Line

1120 Ft. from S. Line

_____ Ft. from E. Line

1120 Ft. from W. Line

		8	

Location _____

Rig up _____

Drilling and Remarks:

L049
2730

RECORD

Cased _____ in., _____ ft.

Sand _____

Gas _____

Oil _____

Total Depth _____

PRODUCTION

1st 24 hrs. Nat. _____

1st 24 hrs. after shot _____

Gas _____ Cu. Ft.

Dry Hole _____

Abandoned **2730'**

Date

JAN 12 1923

191

M. A. BENEAR

Scout