

Marion


FORM 51 10M 12-46 PETROL

KANSAS

Section 28 Township 20 Range 2E

Well No. 1 Suderman

Company Weaver & N C R A

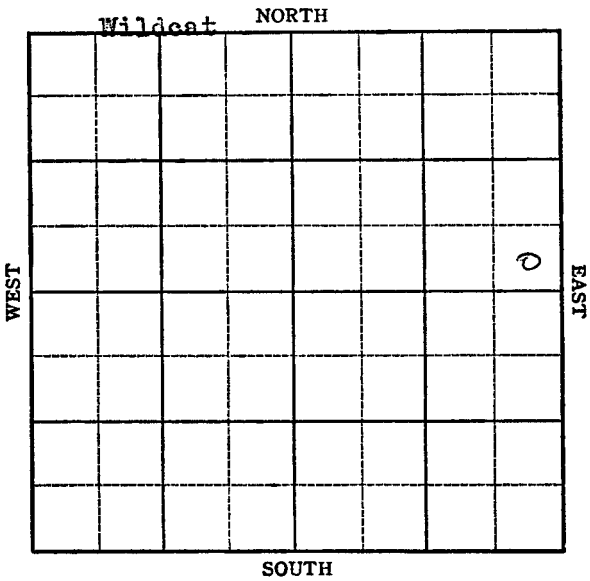

Sec. 28 Twp. 20 R. 2E

Well No. #1 Suderman Farm

Weaver & N. C. R. A. Company

Wildcat


Ft. from N. Line

330 Ft. from S. Line

330 Ft. from E. Line

Ft. from W. Line

SE NE

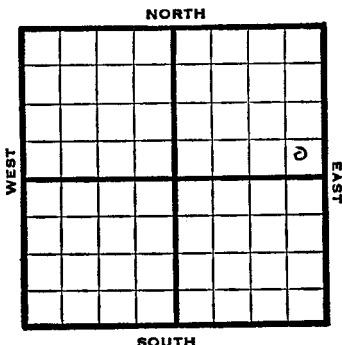

1947	Elev. 1395: REPORT
8/27	8" @ 110' Drlg. 2040'
9/3	Mississippi 2600 Kinderhook 2750 Drlg 2775
9/10	Viola 2943' Simpson Sand 3022' TD 3026' 5" @ 3022'
9/17	Simpson Sand 3022' 5" @ 3022' Total Depth 3026'
	ABANDONED

Map No. _____ Sec. 28 Twp. 20 R. 2E


Well No. 1 Suderman

Weaver & N C R A Company

FIRST REPORT

SE NE Contractor

SECTION PLAT

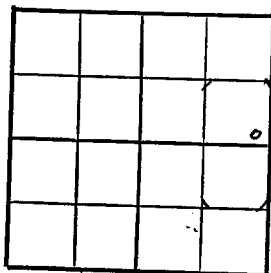

_____ Ft. from N. Line

330 Ft. from S. Line

330 Ft. from E. Line

_____ Ft. from W. Line

Marion County

Location _____

Rig up _____

Drilling and Remarks:

8" @ 110

drlg. 2040

RECORD

Cased _____ in., _____ ft.

Sand _____

Gas _____

Oil _____

Total Depth _____

PRODUCTION

1st 24 hrs. Nat. _____

1st 24 hrs. after shot _____

Gas _____ Cu. Ft.

Dry Hole _____

Abandoned _____

Date

AUG 27 1947

19

S. J. LEWIS

Scout

Wildcat

Form 26 200 Bks. 10-46 Petrol


Kansas

Map No. 24 Sec. 28 Twp. 20 R. 2EWell No. 1 SudermanWeaver & NCRA Company

ABANDONED

Contractor

SE NE

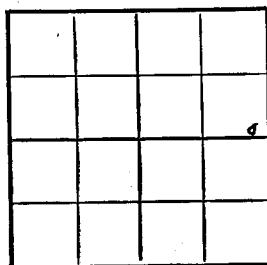E1, 1395
SECTION PLAT Ft. from N. Line330 Ft. from S. Line330 Ft. from E. Line Ft. from W. Line

Marion County

RECORD

Location Cased in., ft.Rig up Sand

Drilling and Remarks:

Gas Oil Total Depth 30263022.

PRODUCTION

5' CO 30221st 24 hrs. Nat. 1st 24 hrs. after shot Gas Cu. Ft.Dry Hole Abandoned

Date

SEP 17 1947

19

S. J. LEWIS

Scout