


marion

Map No. *TAN* Sec. *28* Twp. *20* R. *4*

Well No. *1* *Stafford* Farm

M. K. Bank Company
Hartman & Skar

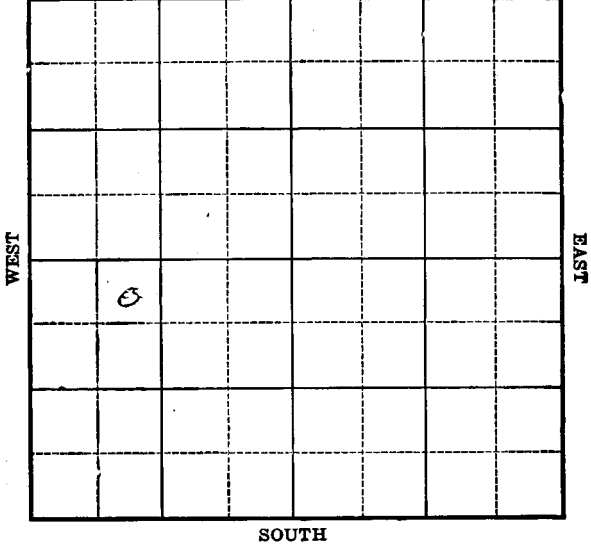

Location _____
Drilling Remarks _____

Rig Up _____
Drilling Remarks _____

RECORD

PRODUCTION

Cased _____ in. _____ ft.

Sand _____

Gas _____

Oil _____

Total Depth _____

1st 24 hrs. Nat. _____

1st 24 hrs. after shot _____

Gas _____ cu. ft.

Dry Hole _____

Abandoned _____

marion

Map No. *T9N* Sec. *28* Twp. *20* R. *4*

Well No. *1* *Stafford* Farm

~~*M. R. Buck*~~ Company

HARTMAN + SKAER


NORTH

330 Ft. from N. Line

..... Ft. from S. Line

..... Ft. from E. Line

990 Ft. from W. Line

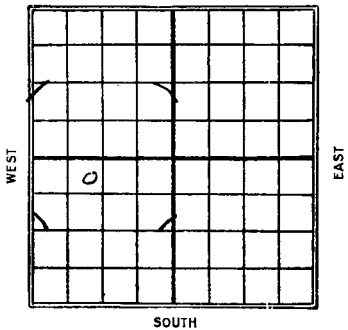

1926

Date	REPORT
------	--------

<i>9/1</i>	<i>Location</i>
------------	-----------------

<i>9/15</i>	_____
-------------	-------

<i>1/22</i>	<i>Rig & took</i>
-------------	-----------------------

<i>2/29</i>	<i>rigging up</i>
-------------	-------------------

<i>10/13</i>	<i>Spudded & S.D.</i>
--------------	---------------------------

<i>1/27</i>	<i>Spudding</i>
-------------	-----------------

<i>1/11</i>	<i>Drill 1000'</i>
-------------	--------------------

<i>1/17</i>	<i>S.D. 1000</i>
-------------	------------------

<i>1/23</i>	<i>S.D. 1000</i>
-------------	------------------

<i>2/8</i>	<i>S.D. 1000 to sell acreage</i>
------------	----------------------------------

<i>2/15</i>	<i>same</i>
-------------	-------------

<i>2/22</i>	_____
-------------	-------

<i>2/30</i>	_____
-------------	-------

<i>1927</i>	_____
-------------	-------

<i>1/6</i>	_____
------------	-------

<i>1/13</i>	_____
-------------	-------

<i>1/19</i>	_____
-------------	-------

<i>1/26</i>	_____
-------------	-------

<i>2/3</i>	_____
------------	-------

<i>2/10</i>	_____
-------------	-------

<i>2/17</i>	_____
-------------	-------

<i>2/24</i>	_____
-------------	-------

3/2 - C.V. T.D. 1000
3/9 _____
3/16 _____
3/24 - Shut Down 1000
3/30 - Skidding rig T.D. 1000
4/7 - Spudding new hole
4/13 - Drilling 400
4/20 - " 1300
4/27 - " 1520
5/5 - " 1850
5/12 - Setting 8" - 2050
5/25 - Abandoned 2578

MAP No. _____ SEC. 28 TWP. 20S R. 4E

WELL No. 1 Stafford
Horsman & Co. & Tubal Oil COMPANY

CONTRACTOR _____

SECTION PLAT

0			

_____ FT. FROM N. LINE
 _____ FT. FROM S. LINE
 _____ FT. FROM E. LINE
 _____ FT. FROM W. LINE

LOCATION _____

RIG UP _____

DRILLING AND REMARKS:

*oil
 core
 my*

RECORD

CASED _____ IN., _____ FT.
 SAND _____
 GAS _____
 OIL _____
 TOTAL DEPTH 2578

PRODUCTION

1ST 24 HRS. NAT. _____
 1ST 24 HRS. AFTER SHOT _____
 GAS _____ CU. FT.
 DRY HOLE ✓
 ABANDONED _____

DATE

May 24 1927

SCOUT

Mallon
28 Sec. 20 Twp. 4 R. ^E

23 KANSAS

Map No. _____ Sec. _____ Twp. _____ R. _____

Well No. _____

Stuffed
Hartman & Sker

Company

Contractor

CORRECTION

330

_____ Ft. from N. Line

_____ Ft. from S. Line

_____ Ft. from E. Line

990

_____ Ft. from W. Line

SECTION PLAT

Location _____

Rig up _____

Drilling and Remarks:

810 1000
by ownership
to show.

RECORD

Cased _____ in., _____ ft.

Sand _____

Gas _____

Oil _____

Total Depth _____

PRODUCTION

1st 24 hrs. Nat. _____

1st 24 hrs. after shot. _____

Gas _____ Cu. Ft.

Dry Hole _____

Abandoned _____

Date

JAN 6 1927

CHAS. L. SHERWOOD

192

Scout

Map No. 23 **KANSAS** Sec. 28 Twp. 20 R. 4

Well No. 1 *Stapp's*

Hartman & Sker Company

Contractor

COMPLETED

SECTION PLAT

230 Ft. from N. Line

----- Ft. from S. Line

----- Ft. from E. Line

990 Ft. from W. Line

0			

ABANDONED

Location -----

Rig up -----

Drilling and Remarks:

Sand 2134-35 14' 50"
Top chat 2196-2307'
RFW 2530'
DH 2578'

RECORD

Cased ----- in., ----- ft.

Sand -----

Gas -----

Oil -----

Total Depth 2578

PRODUCTION

1st 24 hrs. Nat. -----

1st 24 hrs. after shot -----

Gas ----- Cu. Ft.

Dry Hole -----

Abandoned -----

Date

MAY 25 1927

CHAS. L. SHERWOOD

Malloy

Map No. *K 23* **KANSAS** Sec. *28* Twp. *20* R. *4*

Well No. *1* *Stafford*

M. B. Buck Company

Contractor

FIRST REPORTS

SECTION PLAT

330 Ft. from N. Line

Ft. from S. Line

Ft. from E. Line

990 Ft. from W. Line

0			

Location

Rig up

Drilling and Remarks:

RECORD

Cased _____ in., _____ ft.

Sand _____

Gas _____

Oil _____

Total Depth _____

PRODUCTION

1st 24 hrs. Nat. _____

1st 24 hrs. after shot. _____

Gas _____ Cu. Ft.

Dry Hole _____

Abandoned _____

Date

SEP 1 1926

CHAS. L. SHERWOOD
Scout